


# Plat of Survey

of

Lands described in a Warranty Deed recorded in Vol. 631 on Page 3498 as Document No. 290177 as shown below:  
 A part of Lot 8 of Meacham's Park, part of Lot 1 of Harrington Subdivision and part of the unplatted land lying between Meacham's Park and Harrington Subdivision, all located in the NE Fractional 1/4 of Fractional Section 27, T2N, R16E, Walworth County, Wisconsin, described as follows: Commencing at the southeast corner of Meacham's Park; thence S 42° 13' W along the northwesterly line of the Public Road 45.24 feet to the northeast corner of Harrington Subdivision; thence S 49° 48' 30" W along said road 72.02 feet to the place of beginning; thence continue S 49° 48' 30" W along said road 80.34 feet; thence N 57° 36' 30" W 183.57 feet to an iron pipe on the north line of Harrington Subdivision; thence continue N 57° 36' 30" W 39.00 feet to an iron stake; thence continue N 57° 36' 30" W 23.8 feet more or less to the shore of Delavan Lake; thence northeasterly along said shore 80.1 feet; thence S 57° 00' 54" E 2 feet to an iron stake; thence continue S 57° 00' 54" E 105.88 feet to the south line of Meacham's Park; thence continue S 57° 00' 54" E 62.56 feet to the north line of Harrington Subdivision; thence continue S 57° 00' 54" E 85.36 feet to the place of beginning.

Survey Date: October 9, 2002.  
 Revisions: No. 1 - Proposed Add.  
 No. 2 - Elevations  
 No. 3 - 2nd Floor  
 No. 4 - Staking & Spot  
 No. 5 - Foundation  
 No. 6 - Proposed Deck

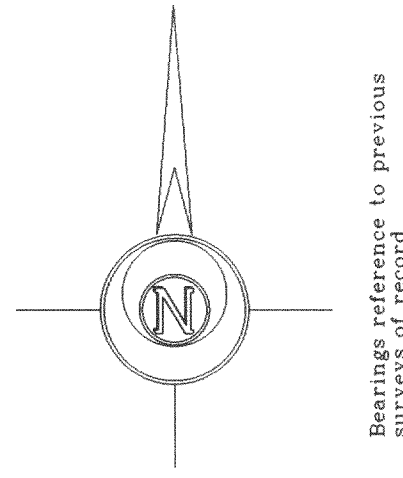


929' 100 year flood boundary elevation of 929 as shown on Flood Insurance Rate Map Community-Panel 550462 0070 B dated August 15, 1983.

Surveyed for: **Steven & Hilary Serafino**  
 995 Lakeland Drive  
 Lake Geneva, Wisconsin. 53147

Delavan Lake

Lot 8  
 Meacham's Park

Lot 7

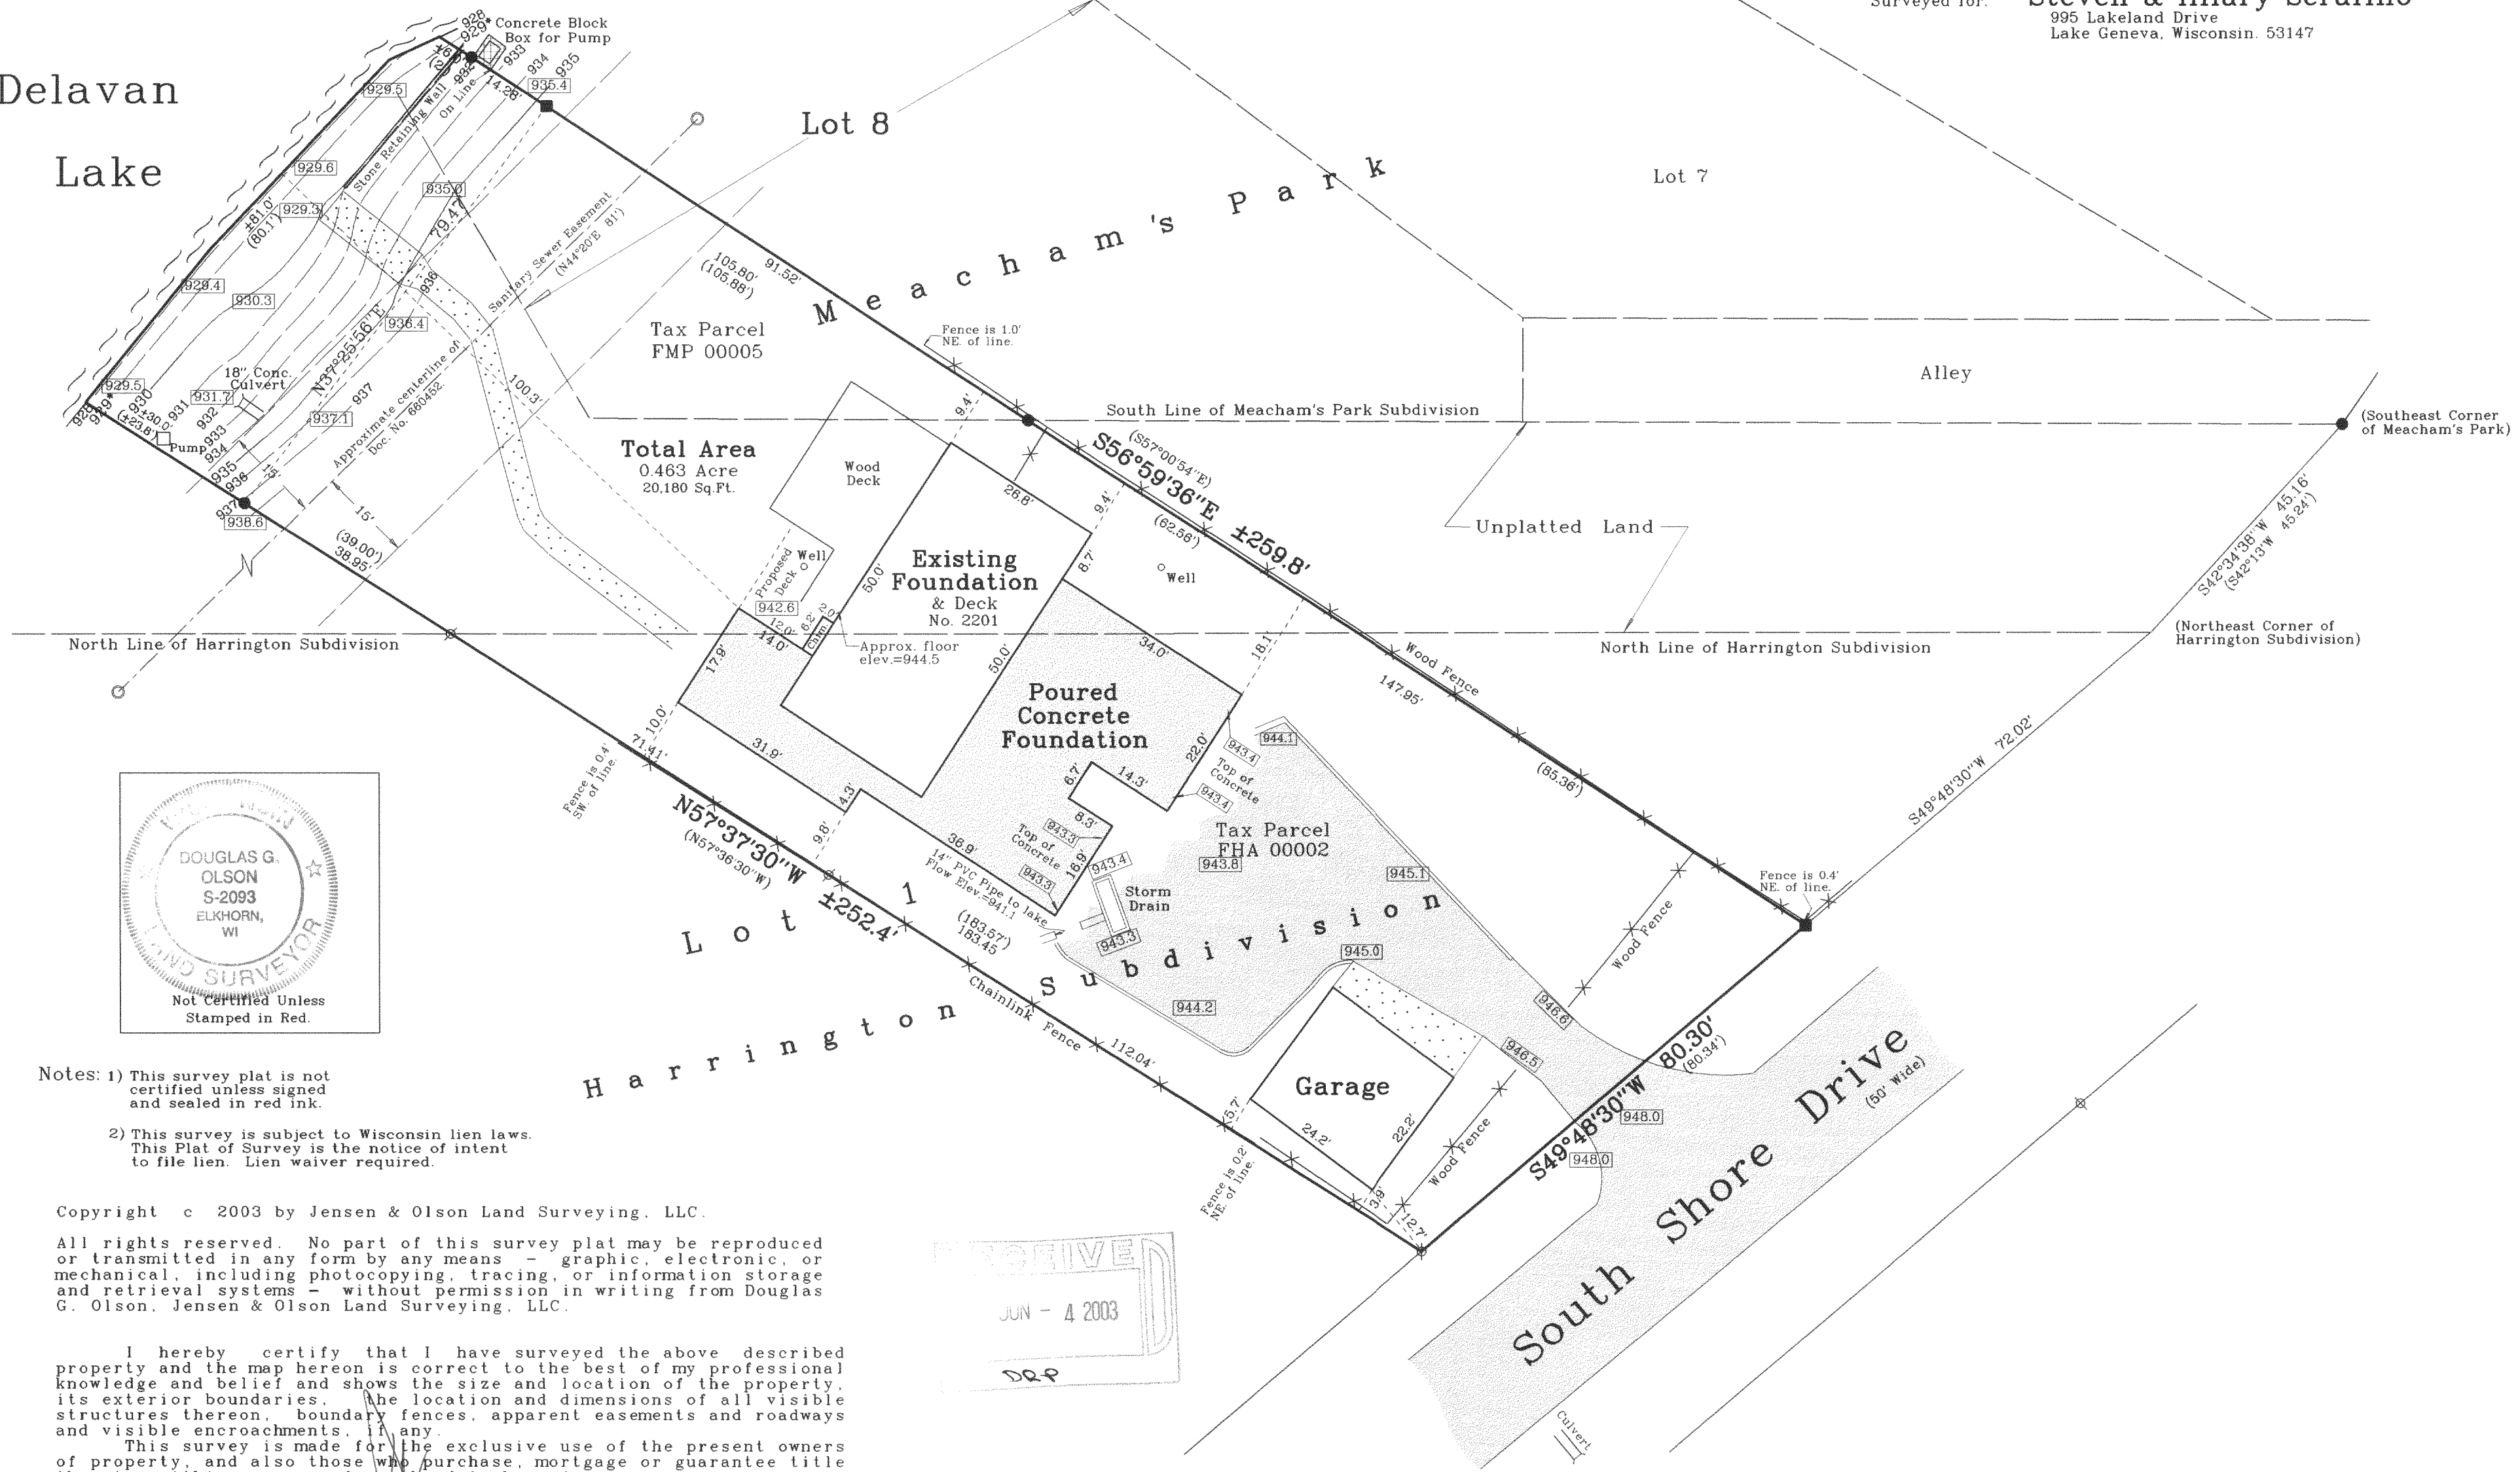

Total Area  
 0.463 Acre  
 20,180 Sq.Ft.


Existing Foundation & Deck  
 No. 2201

Poured Concrete Foundation

Tax Parcel  
 FHA 00002

Garage

South Shore Drive  
 (60' Wide)


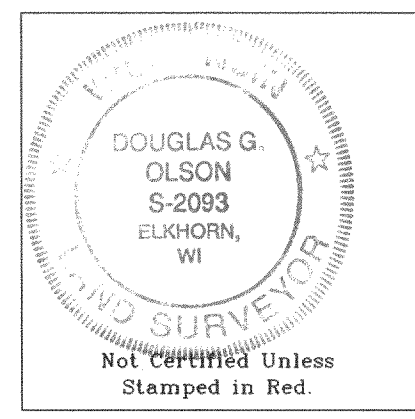


Notes: 1) This survey plat is not certified unless signed and sealed in red ink.  
 2) This survey is subject to Wisconsin lien laws. This Plat of Survey is the notice of intent to file lien. Lien waiver required.

Copyright © 2003 by Jensen & Olson Land Surveying, LLC.  
 All rights reserved. No part of this survey plat may be reproduced or transmitted in any form by any means - graphic, electronic, or mechanical, including photocopying, tracing, or information storage and retrieval systems - without permission in writing from Douglas G. Olson, Jensen & Olson Land Surveying, LLC.

I hereby certify that I have surveyed the above described property and the map hereon is correct to the best of my professional knowledge and belief and shows the size and location of the property, its exterior boundaries, the location and dimensions of all visible structures thereon, boundary fences, apparent easements and roadways and visible encroachments, if any.  
 This survey is made for the exclusive use of the present owners of property and also those who purchase, mortgage or guarantee title thereto, within one year from the date hereof.

Douglas G. Olson  
 Wisconsin Registered Land Surveyor - 2093

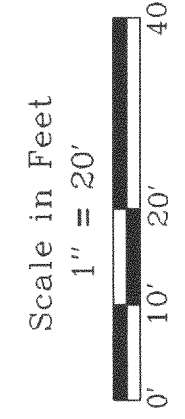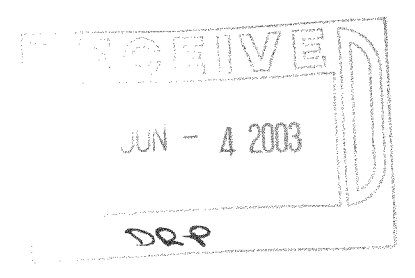

**Jensen & Olson Land Surveying, LLC**  
 45 South Wisconsin Street  
 Elkhorn, Wisconsin. 53121  
 Telephone (262) 723-3434  
 Facsimile (262) 723-8044

**Legend**  
 ■ Found Concrete Monument  
 ⊗ Found Iron Pipe  
 ⊙ Found Iron Rod  
 ○ Recorded Information  
 ○ Manhole  
 ○ Asphalt Surface

Sheet 1 of 1 Sheets  
 Job Reference Number  
**2002.201**

2002.201