


GEORGE T. DUNHAM
 SURVEYING & SUBDIVIDING
 DELAVAN, WISCONSIN

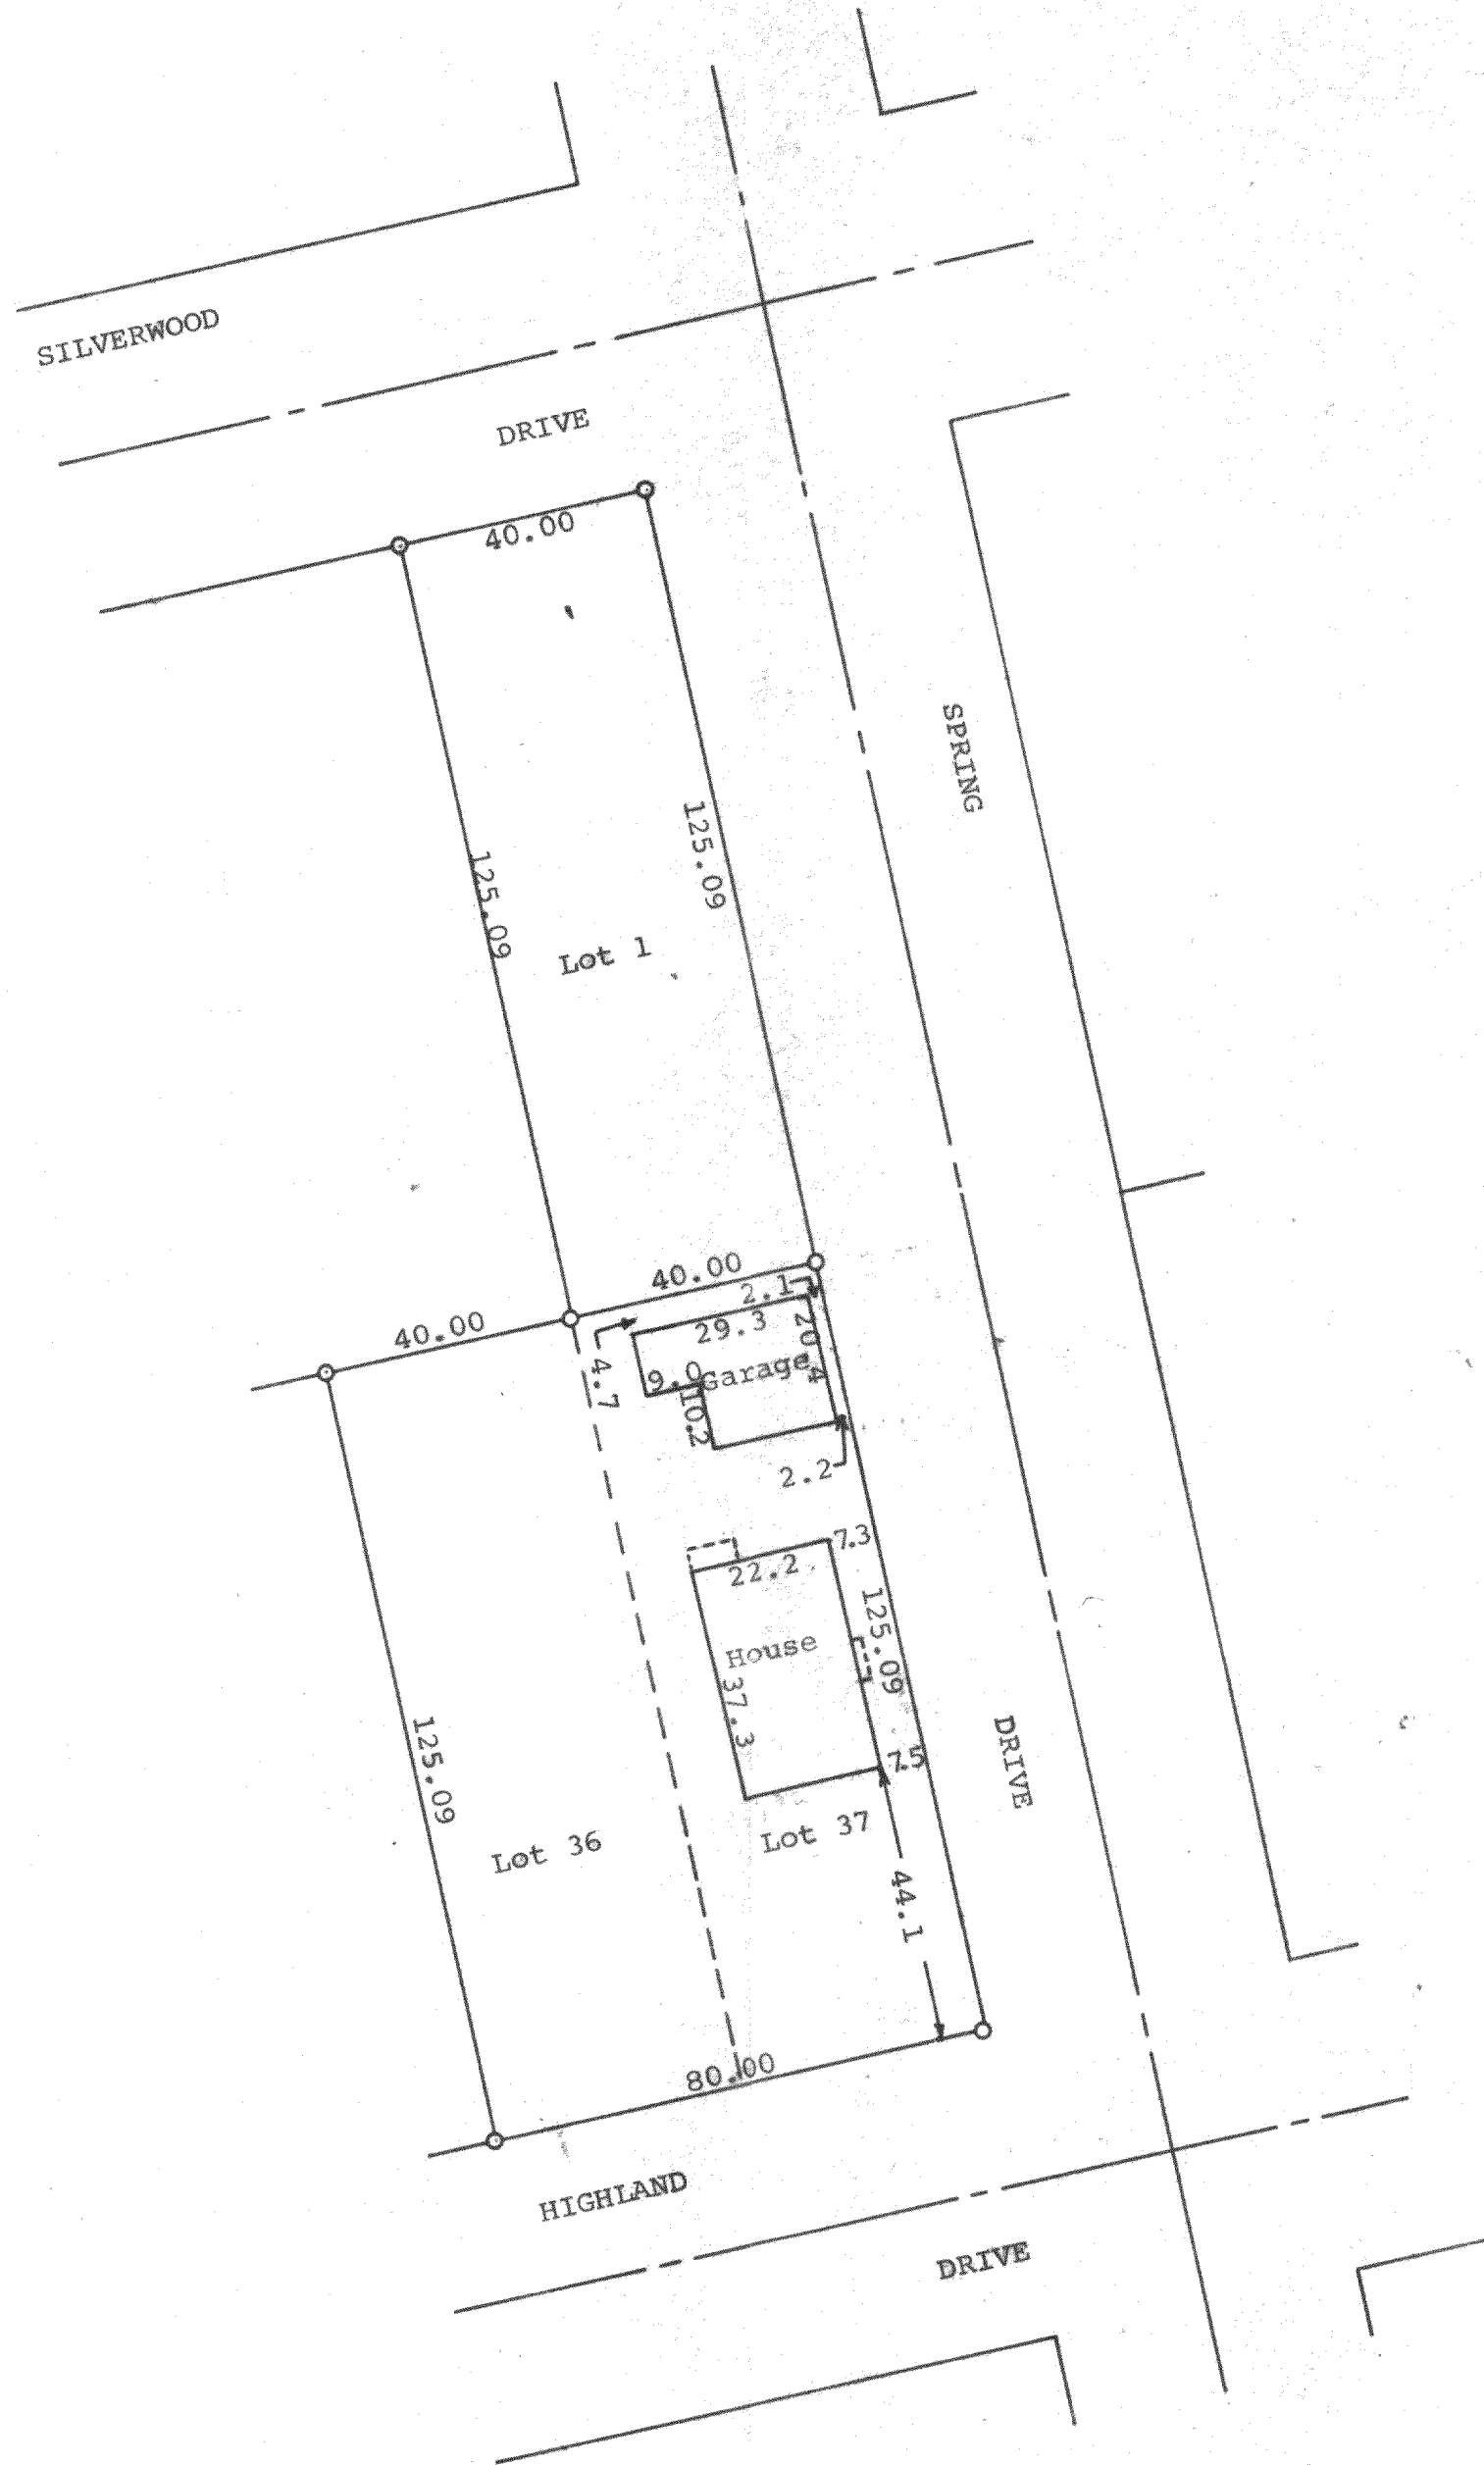

Scale - 1" = 30'
 O = Iron Pipe

STATE OF WISCONSIN) SS
 WALWORTH COUNTY)

I, George T. Dunham, Surveyor, certify that I have surveyed the property described as follows,
 Lots 1, 36, and 37 in Block 15 of Delavan Lake View Crest, a subdivision located in Section 31, T 2 N, R 16 E, Walworth County, Wisconsin,
 and that the above plat is an accurate survey and a true representation thereof and correctly shows the exterior boundary lines and location of buildings on said property and the correct measurements thereof.
 August 28, 1969
 Revised 9/12/69
 Revised 10/1/69

George T. Dunham
 George T. Dunham, Surveyor

FDLV- 71
 FDLV- 87