
PLAT OF SURVEY -OF-

LOT 10 AND THE EAST 1/2 OF LOT 9, BLOCK 1, INLET OAKS SUBDIVISION NO. 4, LOCATED IN SECTION 15, TOWNSHIP 2 NORTH, RANGE 16 EAST IN THE TOWN OF DELAVAN, COUNTY OF WALWORTH AND STATE OF WISCONSIN.

SURVEY FOR: DONNA PEASE

SURVEY LOCATION: 509 DELAVAN DRIVE



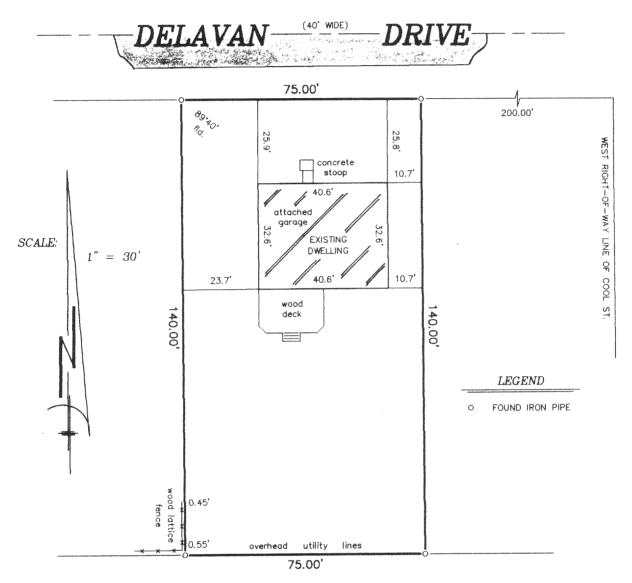


"I hereby certify that I have surveyed the above described property and that the above map is a correct representation thereof and shows the size and location of the property, its exterior boundaries, the location of all visible structures and dimensions of all principal buildings thereon, boundary fences, apparent easements, roadways and encroachments, if any."

"This survey is made for the use of the present owners of the property, and those who purchase, mortgage, or guarantee the title thereto within one year from date hereof."

B.W. SURVEYING, INC.

412 N. PINE STREET

BURLINGTON, WI 53105 (262) - 767 - 0225

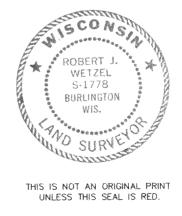

THIS IS NOT AN ORIGINAL PRINT UNLESS THIS SEAL IS RED.

ROBERT J. WETZEL

5919

JUNE 18, 2003

DATE

JOB NUMBER



FIN4-3A1

216-3583