


ABELL SURVEYING & MAPPING

1140 SEQUOIA STREET • DELAVAN, WISCONSIN 53115
262-728-6737

LOT 7

LINCOLN STREET

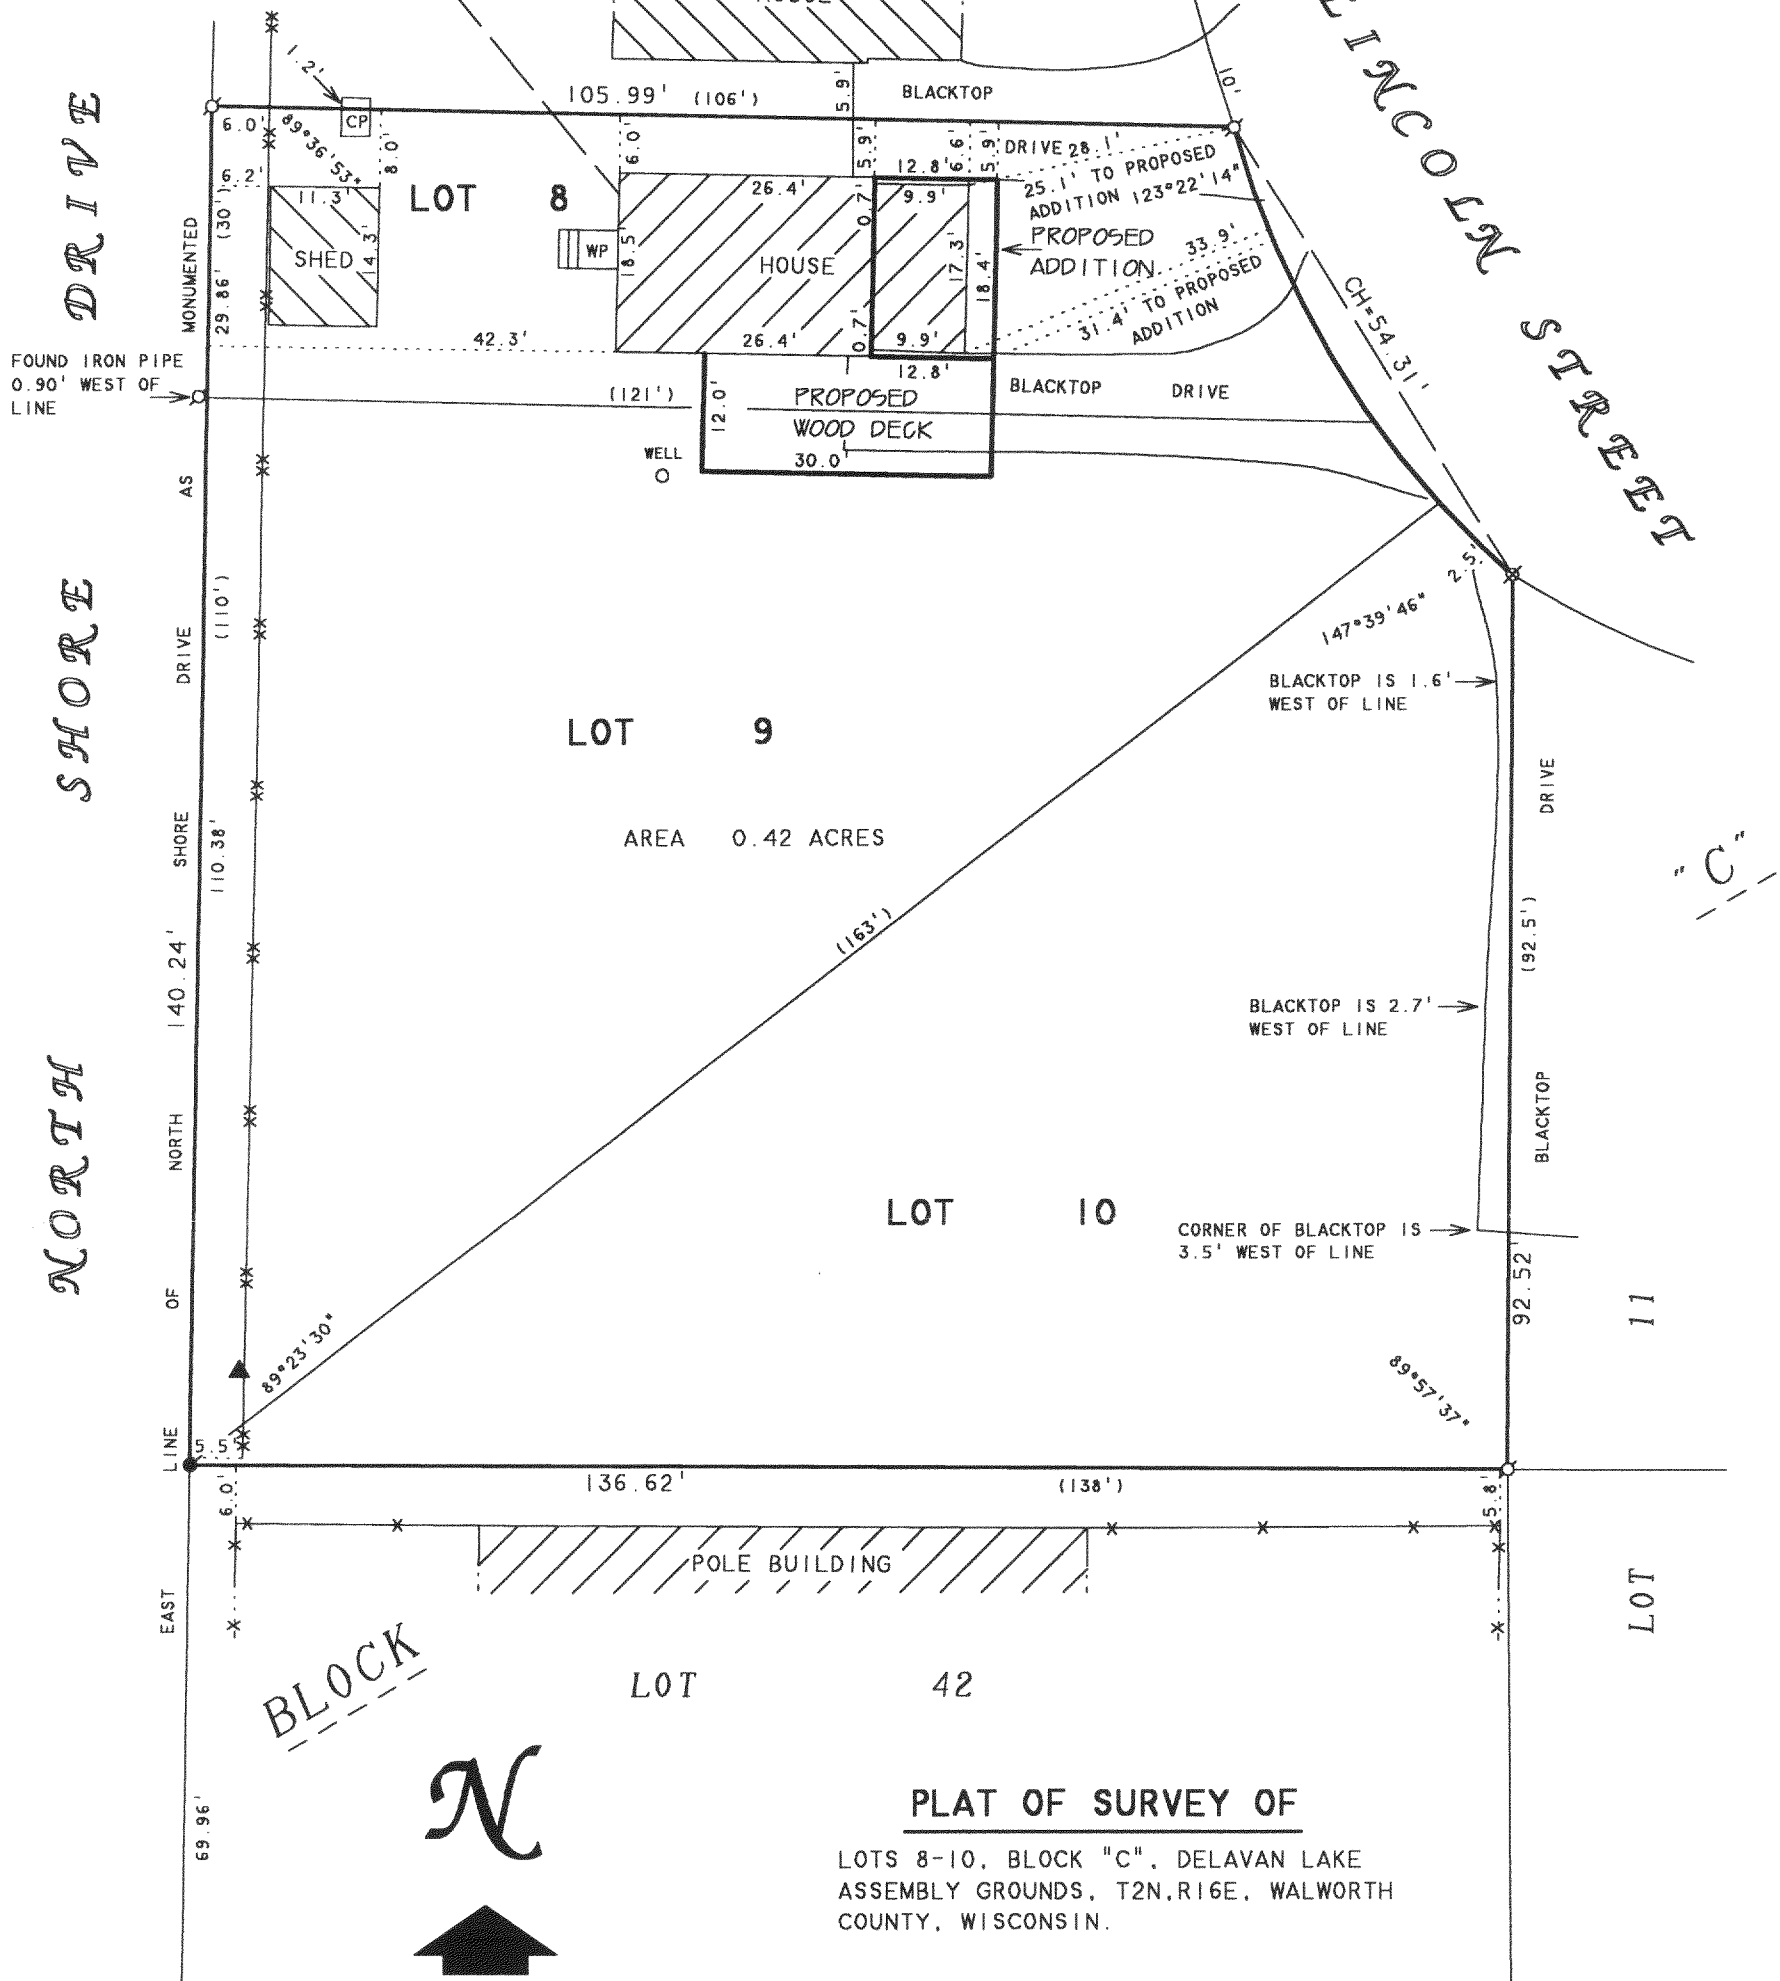

OCT - 3 2003

FDLA-2781

216-3607