

# INLET OAKS DRIVE

## ABELL SURVEYING & MAPPING

1140 SEQUOIA STREET • DELAVAN, WISCONSIN 53115  
262-728-6737

LOT 34

LOT 36

LOT 35  
AREA  
0.3 ACRES ±

### PLAT OF SURVEY OF

LOT 35, THE ANNEX TO INLET OAKS, LOCATED  
IN T2N, R16E, WALWORTH COUNTY, WISCONSIN.

N




SCALE 1"=20'

#### LEGEND

- - IRON PIPE FOUND
- - IRON ROD FOUND
- WS - WOOD STOOP
- XX - WIRE FENCE
- - OVERHEAD UTILITY LINES
- ( ) - RECORDED AS

DELAVAN LAKE INLET

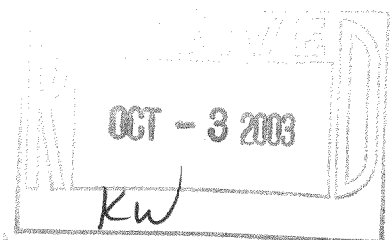

I HEREBY CERTIFY THAT I HAVE SURVEYED THE ABOVE DESCRIBED PROPERTY AND THAT THE ABOVE MAP IS A TRUE REPRESENTATION THEREOF AND SHOWS THE SIZE AND LOCATION OF THE PROPERTY, ITS EXTERIOR BOUNDARIES, THE LOCATION OF ALL VISIBLE STRUCTURES AND DIMENSIONS OF ALL PRINCIPAL BUILDINGS THEREON, BOUNDARY FENCES, APPARENT EASEMENTS, ROADWAYS AND VISIBLE ENCROACHMENTS, IF ANY, TO THE BEST OF MY KNOWLEDGE AND BELIEF.

THIS SURVEY IS MADE FOR THE USE OF THE PRESENT OWNERS OF THE PROPERTY, AND ALSO THOSE WHO PURCHASE, MORTGAGE, OR GUARANTEE THE TITLE THERETO WITHIN ONE (1) YEAR FROM DATE HEREON.

*David F. Abell*

DAVID F. ABELL  
WISCONSIN REGISTERED LAND SURVEYOR, S-1596

*April 16, 1998*

DATE: April 16, 1998 JOB NUMBER - 98057A  
NOTE: THIS IS NOT A CERTIFIED COPY UNLESS SEALED.

REVISED AND RECERTIFIED: JUNE 5, 2003  
ORDERED BY: TOWN & LAKE REAL ESTATE  
3429 SOUTH SHORE DRIVE  
DELAVAN, WI 53115