
ABELL SURVEYING & MAPPING

1140 SEQUOIA STREET . DELAVAN, WISCONSIN 53115



NOTE: BEARINGS ARE REFERENCED TO

EXISTING SURVEY RECORDS.

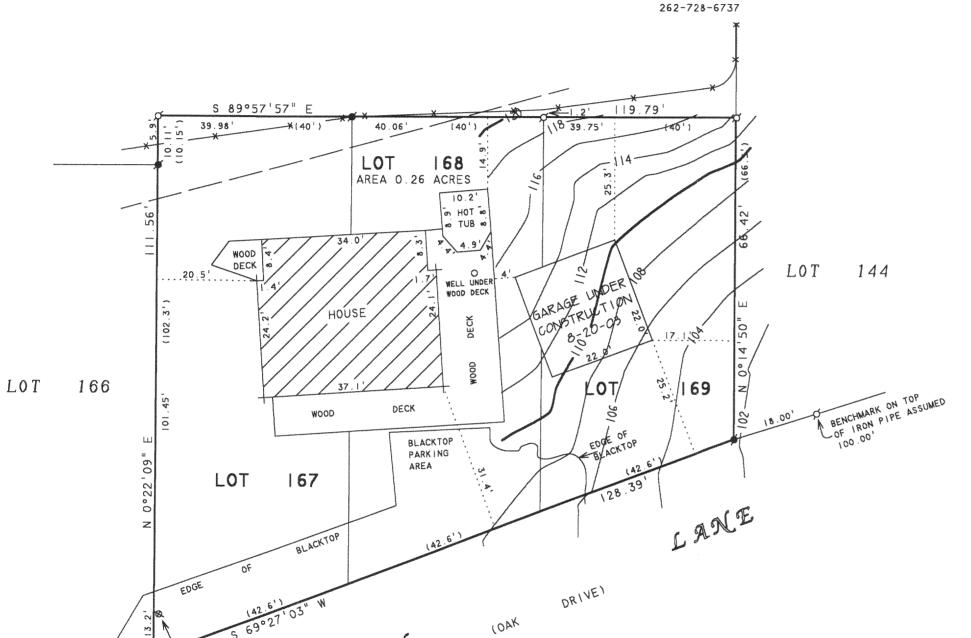



SCALE | " = 20 '

LEGEND

PLAT OF SURVEY OF

LOTS 167-169 AND A TOPOGRAPHIC SURVEY OF LOT 169 AND PART OF LOT 168 OF KRUMHAAR'S 2ND ADDITION TO RAVENSWOOD. LOCATED IN T2N, R16E, WALWORTH COUNTY, WISCONSIN.



I, DAVID F. ABELL, DO HEREBY CERTIFY THAT I HAVE SURVEYED THE PROPERTY HEREON DESCRIBED ACCORDING TO THE OFFICAL RECORDS AND THAT THE PLAT HEREON IS A CORRECT REPRESENTATION OF THE PROPERTY LINES TO THE BEST OF MY KNOWLEDGE AND

DAVID F. ABELL

REVISED DATE: AUGUST 20, 2003. REVISED TO SHOW GARAGE UNDER

FOR: TERRY TRAKSELIS

4010 CARDINAL DRIVE

DELAVAN. WI 53115

ORDERED BY: JIM DAVIS

CONSTRUCTION.

WISCONSIN REGISTERED LAND SURVEYOR, S-1596

June 18, 2003

DATE JOB NUMBER - 89068D NOTE: THIS IS NOT A CERTIFIED COPY UNLESS SEALED.

FRAZ-52