


# ABELL SURVEYING & MAPPING

1140 SEQUOIA STREET • DELAVAN, WISCONSIN 53115  
262-728-6737

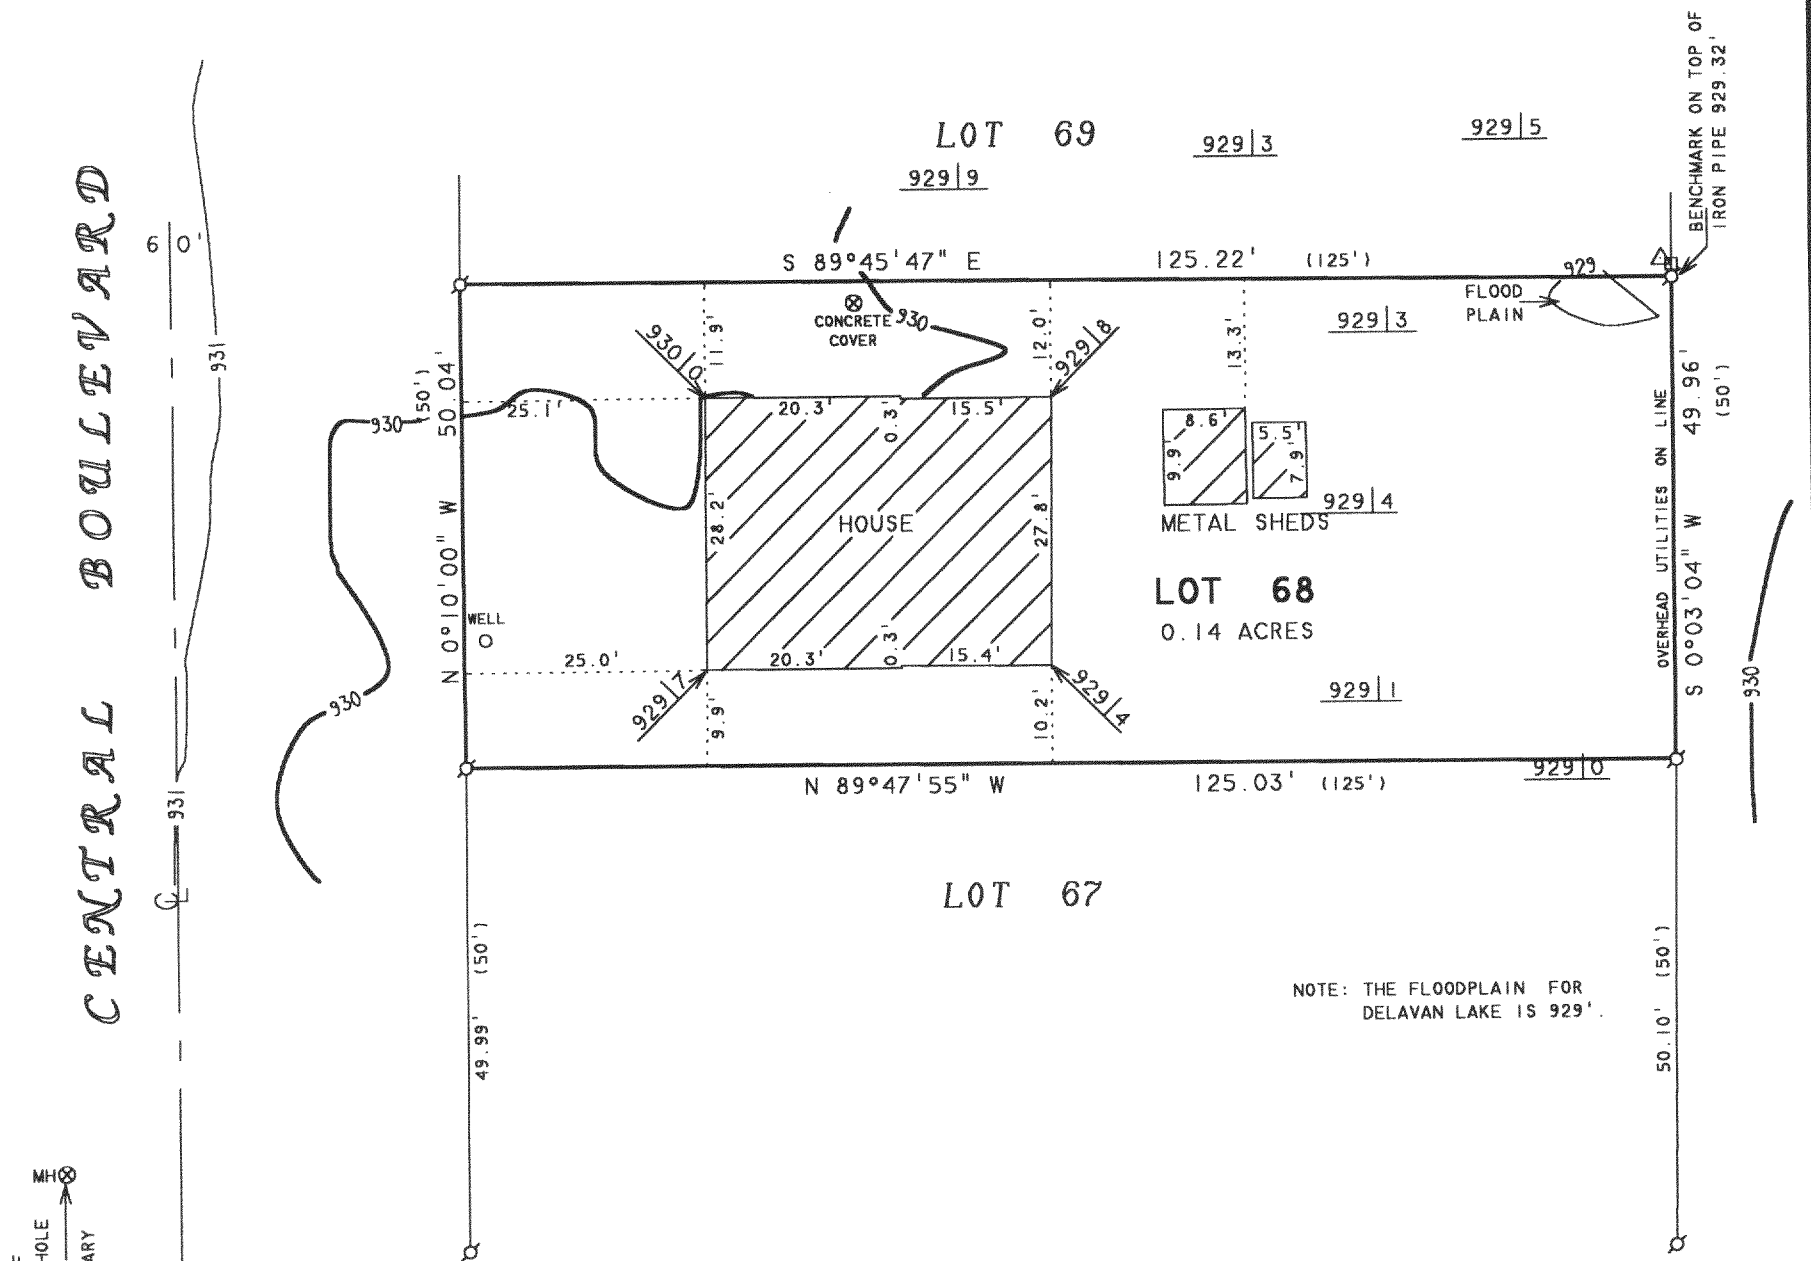


## PLAT OF SURVEY OF

LOT 68 OF LAKE DELAVAN HIGHLANDS, LOCATED IN  
T2N.R16E. WALWORTH COUNTY, WISCONSIN.

REVISED DATE: DECEMBER 2, 2003  
REVISED TO SHOW TOPOGRAPHIC SURVEY.

ORDERED BY: DAN MUDD  
P.O. BOX 546  
BLOOMINGDALE, IL 60108

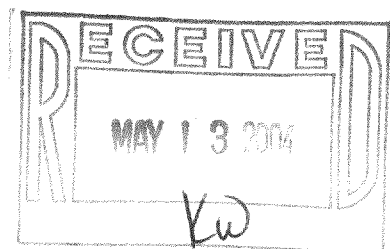

NOTE: BEARINGS ARE REFERENCED TO  
EXISTING SURVEY RECORDS.

N



SCALE 1"=20'

### LEGEND

- Ø - IRON PIPE FOUND
- △ - UTILITY POLE
- - UTILITY PED
- 929/0 - SPOT ELEVATION
- ( ) - RECORDED AS

I HEREBY CERTIFY THAT I HAVE SURVEYED THE ABOVE DESCRIBED PROPERTY AND THAT THE ABOVE MAP IS A TRUE REPRESENTATION THEREOF AND SHOWS THE SIZE AND LOCATION OF THE PROPERTY, ITS EXTERIOR BOUNDARIES, THE LOCATION OF ALL VISIBLE STRUCTURES AND DIMENSIONS OF ALL PRINCIPAL BUILDINGS THEREON, BOUNDARY FENCES, APPARENT EASEMENTS, ROADWAYS AND VISIBLE ENCROACHMENTS, IF ANY, TO THE BEST OF MY KNOWLEDGE AND BELIEF.

THIS SURVEY IS MADE FOR THE USE OF THE PRESENT OWNERS OF THE PROPERTY, AND ALSO THOSE WHO PURCHASE, MORTGAGE, OR GUARANTEE THE TITLE THERETO WITHIN ONE (1) YEAR FROM DATE HEREON.

*David F. Abell*

DAVID F. ABELL  
WISCONSIN REGISTERED LAND SURVEYOR, S-1596

November 12, 2003

DATE: NOVEMBER 12, 2003 JOB NUMBER - 03163A  
NOTE: THIS IS NOT A CERTIFIED COPY UNLESS SEALED.

FLAD 00058

216-3749