PLAT OF SURVEY

ORDERED BY: JAMES DOBSON 4222 CHERRY AVE.

DELAVAN , WI 53115

J.K. SUREVYING, INC.
FORMERLY KOLB LAND CONSULTING
N3705 WILLOW BEND LN. LAKE GENEVA WI
(262) 248-3697


DATE: 6-17-1999 REVISED 8 / 05 / 2003

REVISED 8 / 05 / 2002 DATE OF LAST REVISION: 6 / 28 / 2004

DESCRIPTION:

LOT 19 IN LAKE DELAVAN HIGHLANDS, BEING A SUBSIVISON LOCATED IN THE SOUTH 1/2 OF THE SOUTHEAST 1/4 OF SECTION 31 T2N, R16E, WALWORTH COUNTY, WISCONSIN.

ASSUMED N N SCALE 1"=20'

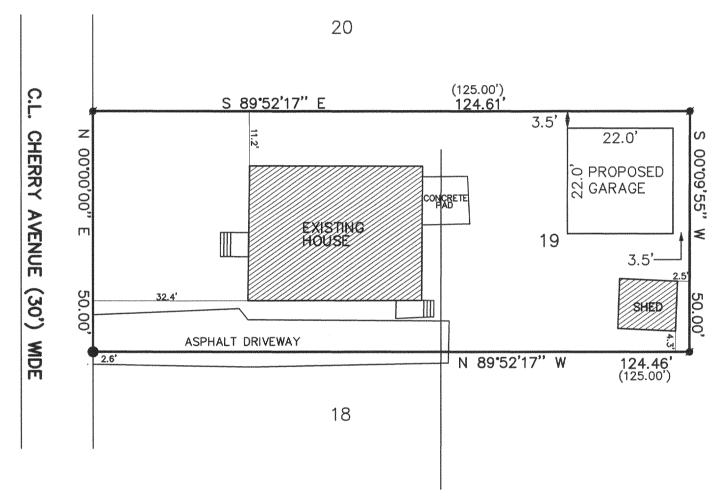

LEGEND


- Ø FOUND IRON PIPE
- SET IRON PIPE
- SET RAILROAD SPIKE

(XXX) RECORDED AS

THE ABOVE MAP IS A TRUE REPRESENTATION THEREOF AND SHOWS THE SIZE AND LOCATION OF ALL THE PROPERTY, EXTERIOR BOUNDARIES, THE LOCATION OF ALL VISIBLE BOUNDARY FENCES, APPARENT EASEMENTS, ROADWAYS AND VISIBLE ENCROACHMENTS, IF ANY

THIS SURVEY IS MADE FOR THE USE OF THE PRESENT OWNERS OF THE PROPERTY , AND ALSO THOSE WHO PURCHASE , MORTGAGE OR GURANTEE TITLE THERETO WITHIN ONE (1) YEAR FROM DATE HERETO.

JOHN P. KROTT , R.L.S. 2258

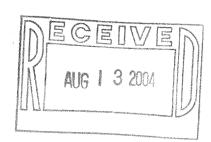



NOTE: THIS IS NOT A CERTIFIED COPY UNLESS SEAL IS IN RED.

JOB NUMBER 99134 2-16 FLAD 00017

FLAD 80017