

PLAT OF SURVEY

LOT 1 OF CERTIFIED SURVEY MAP NO. 3616

LOCATED IN THE SE 1/4 OF THE SW 1/4 OF SECTION 29 AND THE NE 1/4 OF THE NW 1/4 OF SECTION 32, TOWN 2 NORTH, RANGE 16 EAST, WALWORTH COUNTY, WISCONSIN

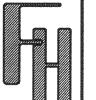

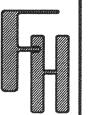

NORTH SHORE DRIVE. DEDICATED TO THE PUBLIC DEED RESTRICTI AREA SHORELAND -BOUNDARY EXISTING -SOUTH 1/4 CORNER 135' SETBACK -SEC. 29-02-16 FROM LAKE 220,543.97 N (IN LAKE) --SW CORNER SEC. 29-02-16 220,501.80 N 2,366,419.84 E N 89°03'04" E / 619.53' N 89'03'04" E 2020.80' DEED RESTICTED AREA --MEANDER CORNER SEC. 29-02-16 EXISTING 220,533.71 N BUILDINGS -2,368,440.40 E JONG
30' WDE SANITARY
SEWER EASEMENT -FLOODPLAIN LINE

LEGEND


O = FOUND IRON PIPE STAKE, 1 1/8" O.D.

= FOUND IRON REBAR STAKE, 3/4" DIA.


= FOUND CONCRETE COUNTY MONUMENT
W/ BRASS CAP

= SET IRON REBAR STAKE 3/4" DIA. x
24" x 1.5 LBS./FT.

(XXX) = RECORDED AS

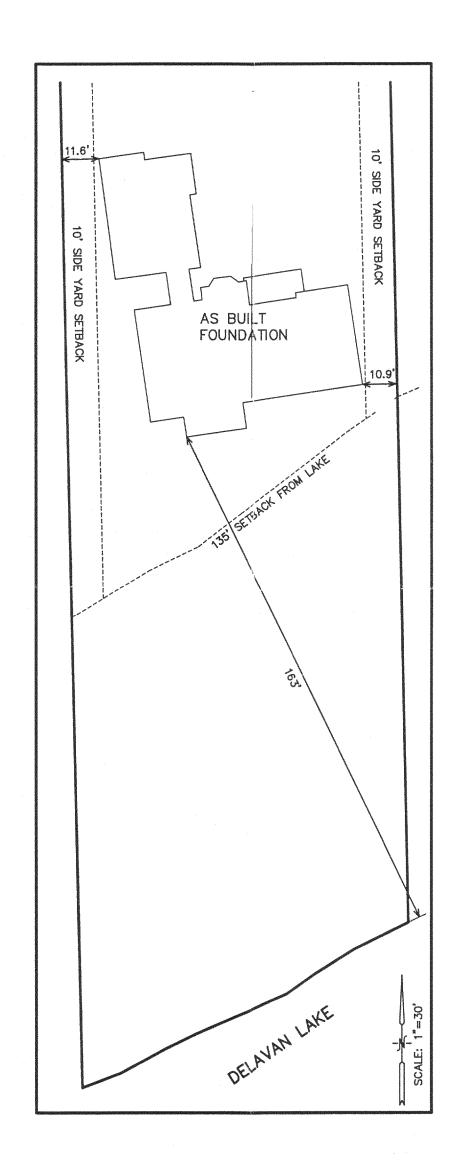

AUG 2 4 2004

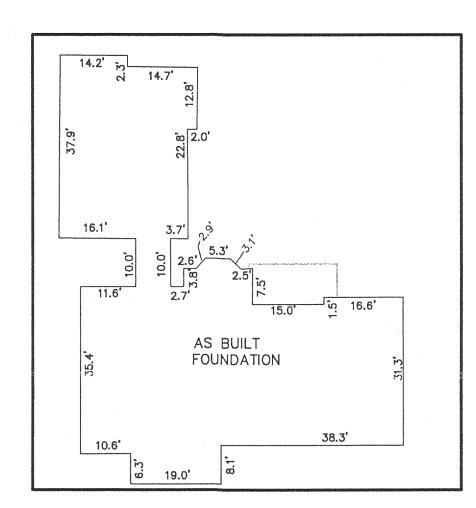

NOTE: COPIES OF THIS MAP TO WHICH THE FOLLOWING CERTIFICATE WILL APPLY SHOW THE SURVEYOR'S ORIGINAL SEAL AND SIGNATURE IN RED INK. COPIES BY ANY OTHER MEANS MAY HAVE ALTERATIONS WHICH DO NOT REPRESENT THE SURVEYOR'S WORK PRODUCT.

I HEREBY CERTIFY THAT THE ABOVE DESCRIBED PROPERTY HAS BEEN SURVEYED UNDER MY DIRECTION AND THAT THE ABOVE MAP IS A TRUE REPRESENTATION THEREOF AND SHOWS THE SIZE AND LOCATION OF THE PROPERTY AND ITS EXTERIOR BOUNDARIES. THIS SURVEY IS MADE FOR THE USE OF THE PRESENT OWNERS OF THE PROPERTY, AND ALSO THOSE WHO PURCHASE, MORTGAGE, OR GUARANTEE THE TITLE THERETO WITHIN ONE YEAR FROM THE DATE HEREOF.

03/05/2004

REVISED 07-19-2004 TO SHOW SIZE & LOCATION OF AS BUILT FOUNDATION

PETER S. GORDON R.L.S. 2101

DATED:

PROJECT NO. 6133.01 DATE:

FARRIS, ENGINEEI

REVISIONS

03/05/2004 SHEET NO. 1 OF 1

FA361600001

MAP SCALE IN FEET ORIGINAL 1"= 150'