


## ABELL SURVEYING & MAPPING

1140 SEQUOIA STREET . DELAVAN, WISCONSIN 53115 262-728-6737

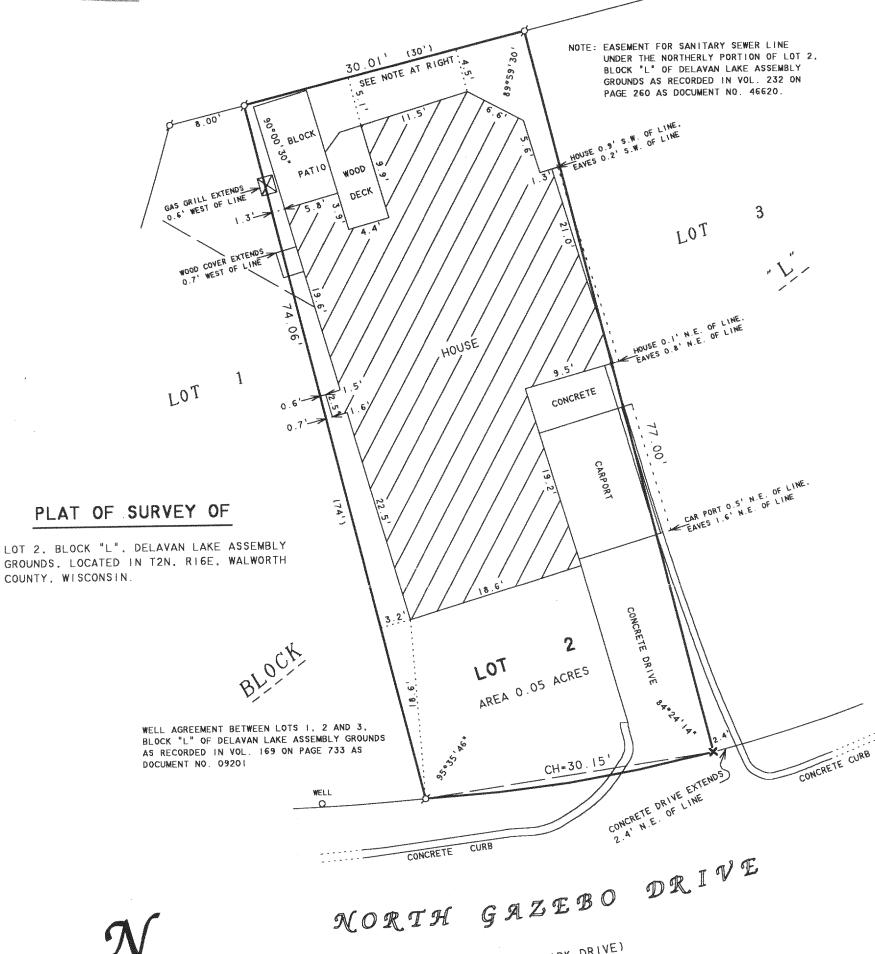

SCALE I"=10

LEGEND

Ø -IRON PIPE FOUND -CUT CROSS IN CONCRETE FOUND

-OVERHEAD UTILITY LINES ( )-RECORDED AS

I HEREBY CERTIFY THAT I HAVE SURVEYED THE ABOVE DESCRIBED PROPERTY AND THAT THE ABOVE MAP IS A TRUE REPRESENTATION THEREOF AND SHOWS THE SIZE AND LOCATION OF THE PROPERTY, ITS EXTERIOR BOUNDARIES, THE LOCATION OF ALL VISIBLE STRUCTURES AND DIMENSIONS OF ALL PRINCIPAL BUILDINGS THEREON, BOUNDARY FENCES, APPARENT EASEMENTS, ROADWAYS AND VISIBLE ENCROACHMENTS, IF ANY, TO THE BEST OF MY KNOWLEDGE AND BELIEF.

(NORTH PARK DRIVE)

THIS SURVEY IS MADE FOR THE USE OF THE PRESENT OWNERS OF THE PROPERTY, AND ALSO THOSE WHO PURCHASE, MORTGAGE, OR GUARANTEE THE TITLE THERETO WITHIN ONE (I) YEAR FROM DATE HEREON.

WISCONSIN REGISTERED LAND SURVEYOR, S-1596

ORDERED BY: WASSEL LAW OFFICE 1034 ANN STREET

DELAVAN, WI 53115

DATE NOTE: THIS IS NOT A CERTIFIED COPY UNLESS SEALED.

September 14, 2004