
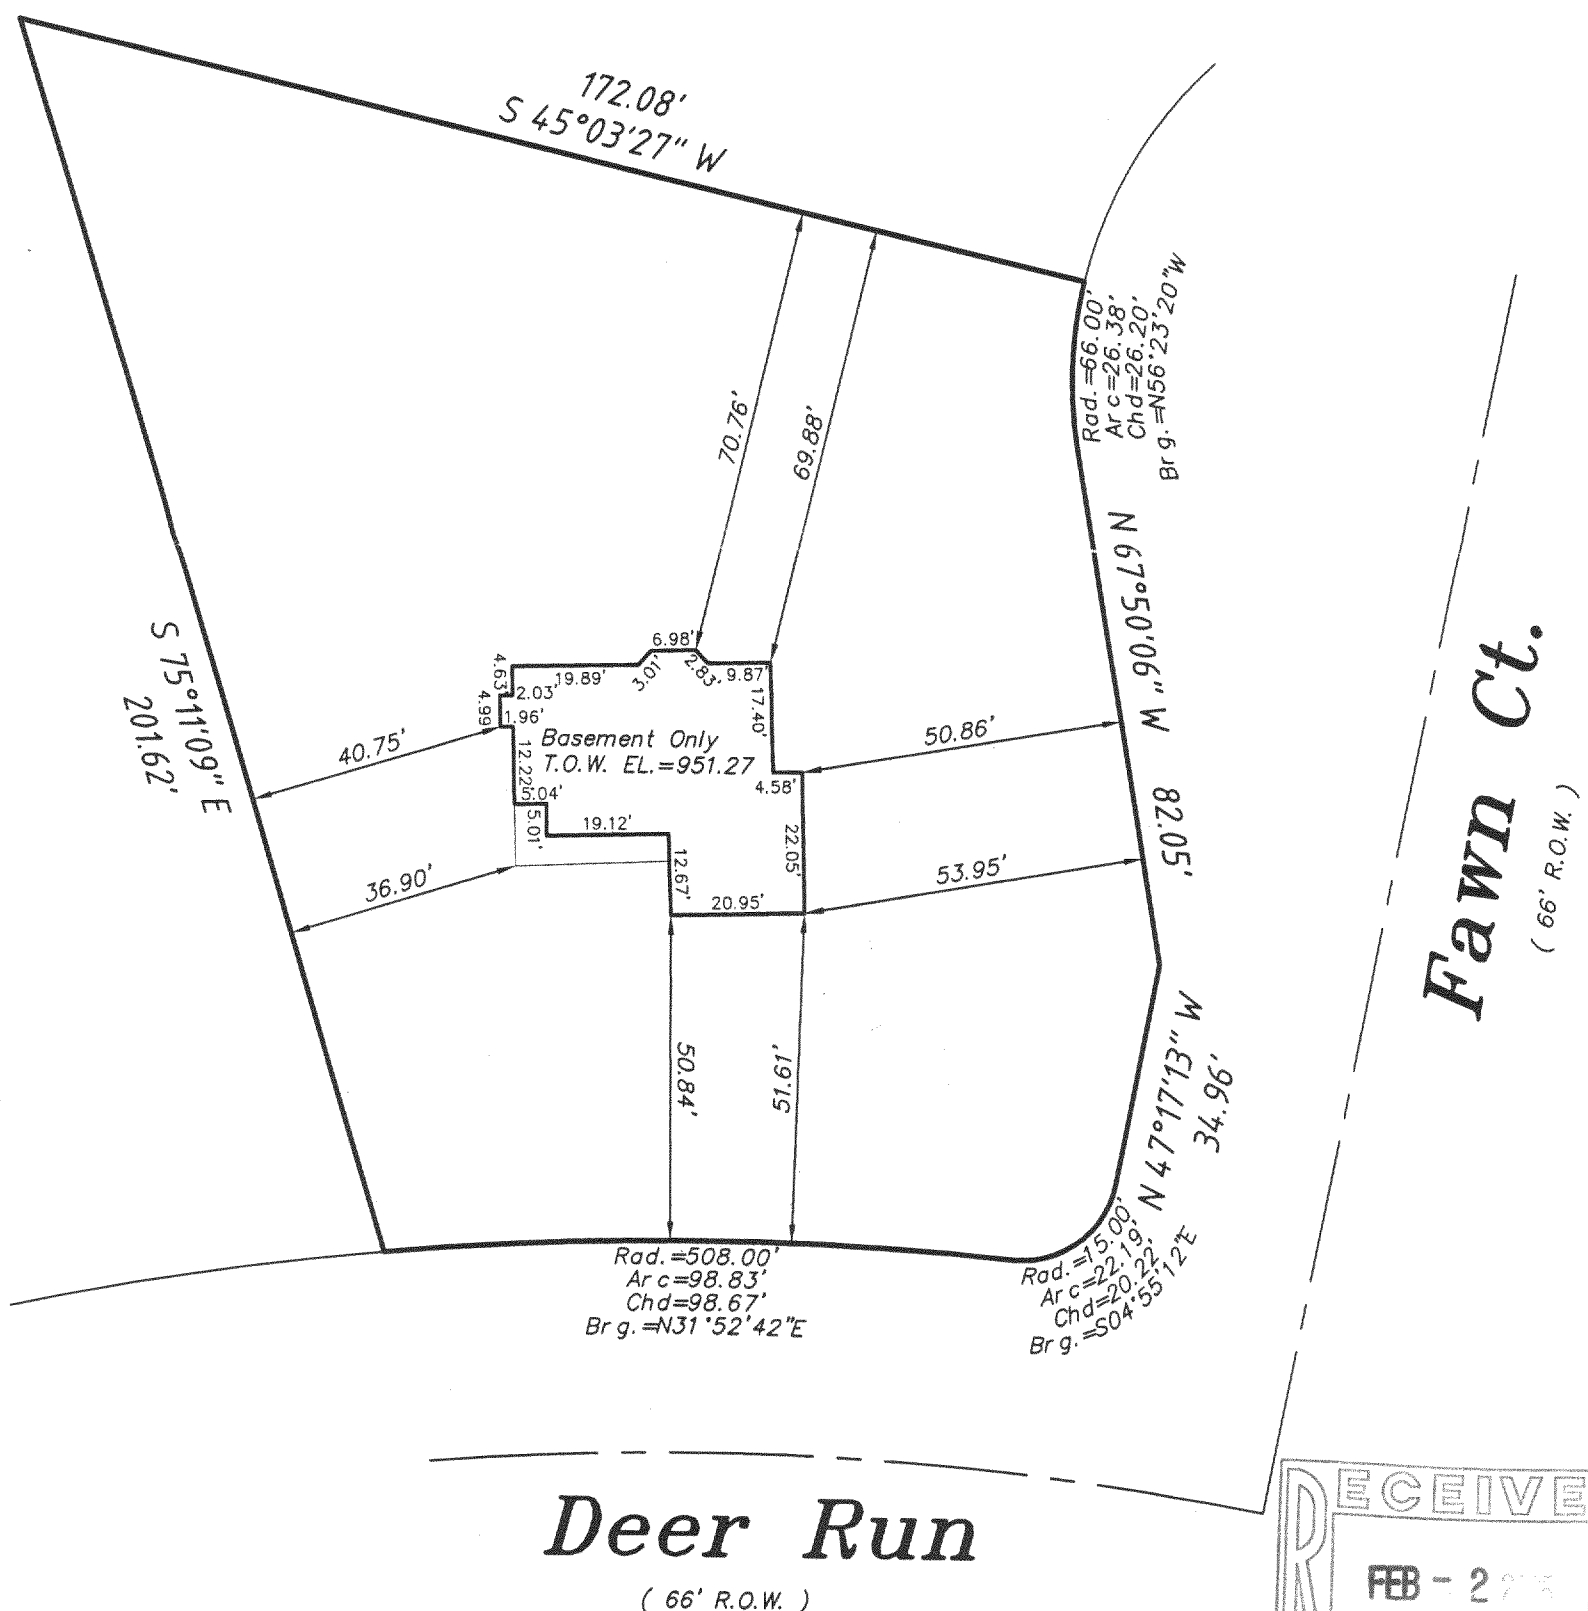


LEGAL DESCRIPTION:

Survey No. 98149

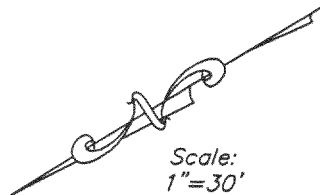

SIGNED

Dennis C. Sauer
Registered Land Surveyor S-2421