

ABELL SURVEYING & MAPPING

1140 SEQUOIA STREET . DELAVAN, WISCONSIN 53115 262-728-6737

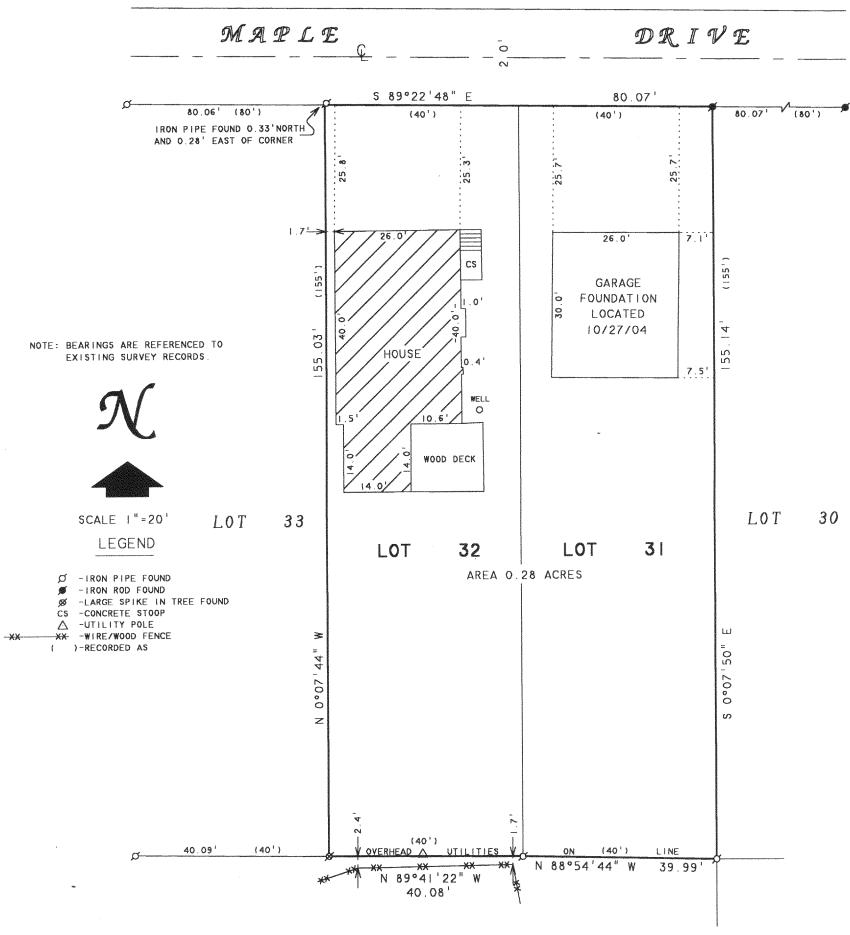

PLAT OF SURVEY OF

LOTS 31 AND 32, KRUMAAR'S ADDITION TO RAVENSWOOD. LOCATED IN T2N, RIGE, WALWORTH COUNTY.

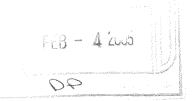

I HEREBY CERTIFY THAT I HAVE SURVEYED THE ABOVE DESCRIBED PROPERTY AND THAT THE ABOVE MAP IS A TRUE REPRESENTATION THEREOF AND SHOWS THE SIZE AND LOCATION OF THE PROPERTY, ITS EXTERIOR BOUNDARIES, THE LOCATION OF ALL VISIBLE STRUCTURES AND DIMENSIONS OF ALL PRINCIPAL BUILDINGS THEREON, BOUNDARY FENCES, APPARENT EASEMENTS, ROADWAYS AND VISIBLE ENCROACHMENTS, IF ANY, TO THE BEST OF MY KNOWLEDGE AND BELIEF.

THIS SURVEY IS MADE FOR THE USE OF THE PRESENT OWNERS OF THE PROPERTY, AND ALSO THOSE WHO PURCHASE, MORTGAGE, OR GUARANTEE THE TITLE THERETO WITHIN ONE (1) YEAR FROM DATE HEREON.

DAVID F. ABELL WISCONSIN REGISTERED LAND SURVEYOR. S-1596

ORDERED BY: JIM DAVIS 3321 N. SHORE DRIVE DELAVAN, WI 53115

REVISED: OCTOBER 27, 2004 TO SHOW THE LOCATION OF THE GARAGE FOUNDATION.

September 28, 2004

DATE JOB NUMBER - 04109A NOTE: THIS IS NOT A CERTIFIED COPY UNLESS SEALED.