
Plat of Survey


Lot 7 of Block 1 of Potter's Subdivision,


of part of the fractional Southwest 1/4 of Section 32, Town 2 North, Range 16 East, Town of Delavan, Walworth County, Wisconsin.


Shodeen Construction Companny, Inc. Surveyed for:

17 North First Street Geneva, Illinois. 60134

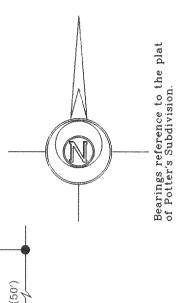

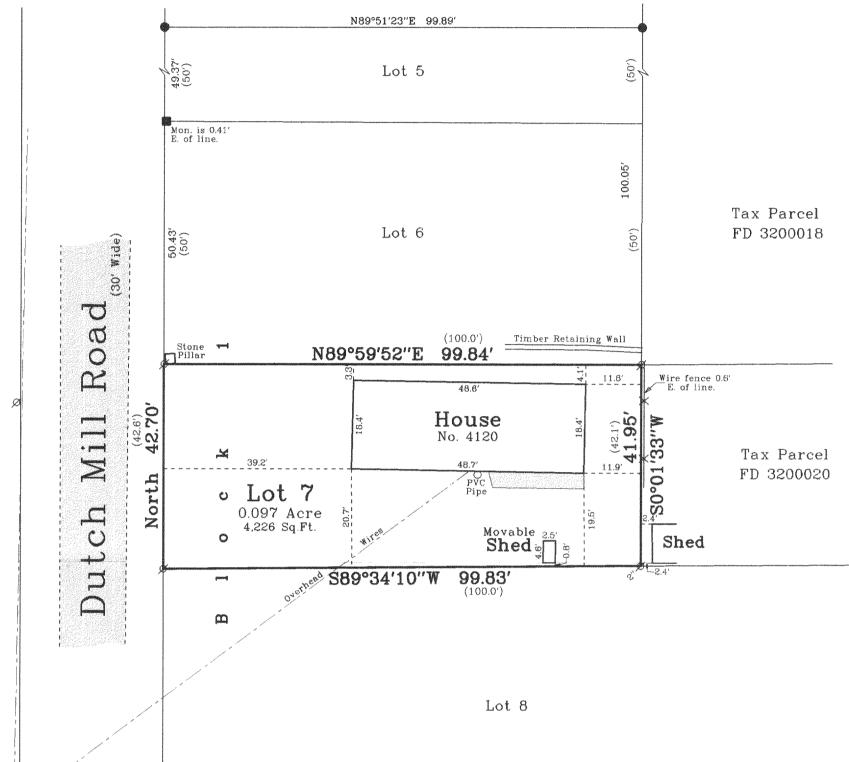

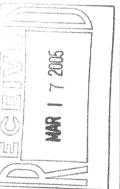

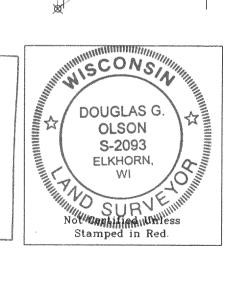

Notes: 1) This survey plat is not certified unless signed and sealed in red ink.

2) This survey is subject to Wisconsin lien laws. This Plat of Survey is the notice of intent to file lien. Lien waiver required.

Copyright c 2005 by Jensen & Olson Land Surveying, LLC.

All rights reserved. No part of this survey plat may be reproduced or transmitted in any form by any means — graphic, electronic, or mechanical, including photocopying, tracing, or information storage and retrieval systems - without permission in writing from Douglas G. Olson, Jensen & Olson Land Surveying, LLC.

I hereby certify that I have surveyed the above described property and the map hereon is correct to the best of my professional knowledge and belief and shows the size and location of the property, its exterior boundaries, the location and dimensions of all visible structures thereon, boundary fences, apparent easements and roadways and visible encroachments, if

This survey is made for the exclusive use of the present owners of property, and also those who purchase, mortgage or guarantee title thereto, within one year from the date hereof.

Douglas G. Olson Wisconsin Registered Land Surveyor - 2093

Legend

- Found Concrete Monument
- Ø Found Iron Pipe Found Iron Rod
- () Recorded Information
- ▼ Utility Pole Concrete Surface

FPO-8

IIIGravel Surface

Jensen & Olson Land Surveying, LLC

45 South Wisconsin Street P.O. Box 322 Elkhorn, Wisconsin. 53121 Telephone: (262) 723-3434

> 10 20, 40' 60

Survey date: March 11, 2005. Revisions:

Sheet 1 of 1 Sheets.

Job Reference Number:

2005.031 2/6-3943

Facsimile: (262) 723-8044 Scale: 1'' = 20'