## **PLAT OF SURVEY**


LOCATION:

South Shore Drive, Delavan, Wisconsin

**LEGAL DESCRIPTION:** Lots 10 and 11 in **DELMAR SUBDIVISION**, located in Section 27, Town 2 North, Range 16 East, Walworth County, Wisconsin

May 10, 2005
Revised Drawing May 18, 2005
Restaked 5-20-05

Survey No. 98504

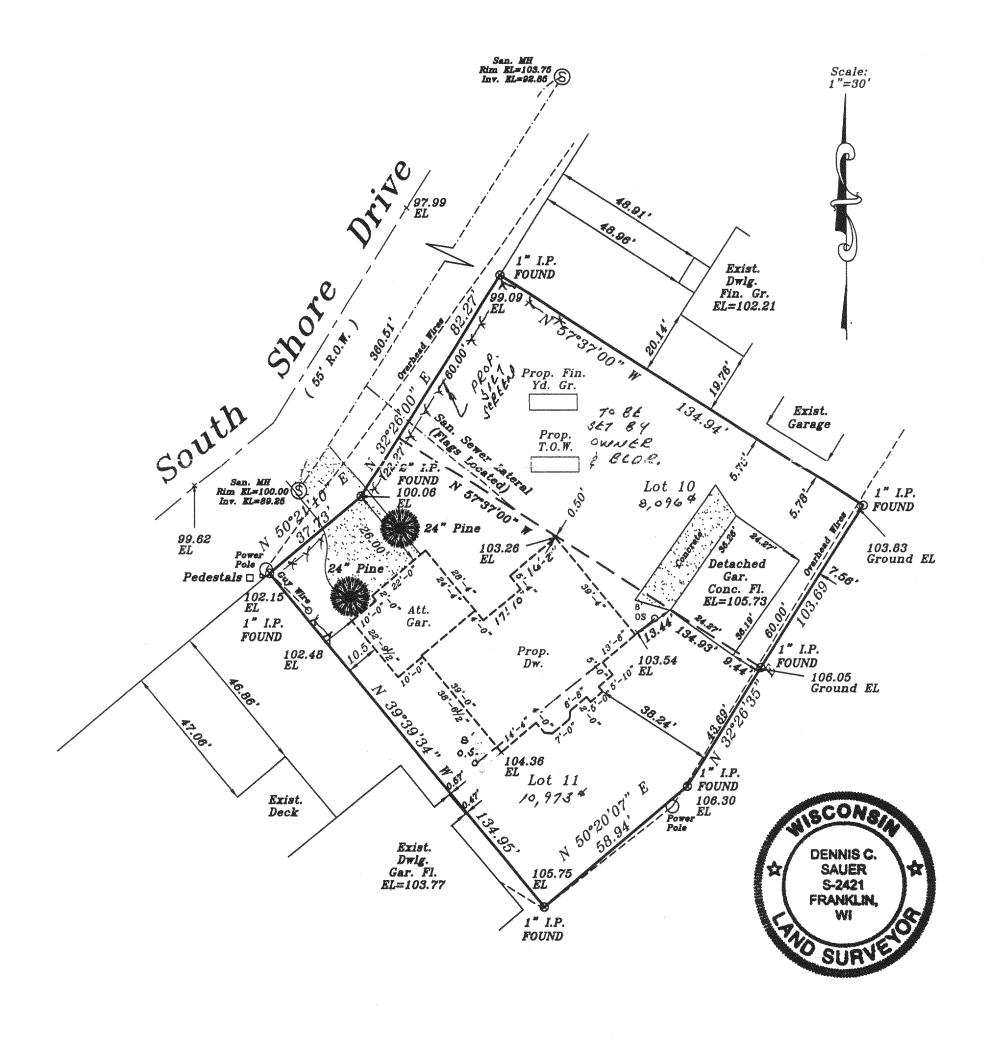

## **METROPOLITAN SURVEY SERVICE, INC.**

REGISTERED LAND SURVEYORS AND CIVIL ENGINEERS 5200 W. LOOMIS ROAD GREENDALE, WI 53129

PH. (414) 529-5380 FAX (414) 529-9787 email address survey@bizwi.rr.com

Proposed finished year, he floor or top of top-define guide teams and the second secon

JUN 3 2005

I HEREBY CERTIFY THAT I HAVE SURVEYED THE ABOVE DESCRIBED PROPERTY AND THAT THE ABOVE MAP IS A TRUE REPRESENTATION THEREOF AND SHOWS THE SIZE AND LOCATION OF THE PROPERTY. ITS EXTERIOR BOUNDARIES, THE LOCATION OF ALL VISIBLE STRUCTURES AND DIMENSIONS OF ALL PRINCIPAL BUILDINGS THEREON, BOUNDARY FENCES, APPARENT EASEMENTS AND ROADWAYS AND VISIBLE ENCROACHMENT, IF ANY.

THIS SURVEY IS MADE FOR THE EXCLUSIVE USE OF THE PRESENT OWNERS OF THE PROPERTY, AND ALSO THOSE WHO PURCHASE, MORTGAGE, OR GUARANTEE THE TITLE THERETO WITHIN ONE (1) YEAR FROM THE DATE HEREOF.

SIGNED Dennis C. Sauer

Dennis C. Sauer
Registered Land Surveyor S-2421