Re: Richard Laboury

PREPARED FOR: CENTURY 21 ZENK REALTY, LLC 804 N. WISCONSIN STREET ELKHORN, WI, 53121


PLAT OF SURVEY

I.K. SURVEYING INC. N3705 WILLOWBEND LANE LAKE GENEVA, WI, 53147 262-248-3697

- OF -

PARCEL A : LOTS 27 & 28 EXCEPT THE EASTERLY 10' OF LOT 28 , BLOCK 14 DELAVAN LAKE VIEW CREST SUBDIVISION, A SUBDIVISION LOCATED IN SECTION 31 TOWN 2 NORTH, RANGE 16 EAST OF THE FOUTH PRINCIPLE MERIDIAN, TOWN OF DELAVAN, WALWORTH COUNTY, WISCONSIN

PARCEL B : THE WEST 1/2 OF LOT 30 & LOTS 29, & THE EASTERLY 10' OF LOT 28 , BLOCK 14 DELAVAN LAKE VIEW CREST SUBDIVISION, A SUBDIVISION LOCATED IN SECTION 31 TOWN 2 NORTH, RANGE 16 EAST OF THE FOUTH PRINCIPLE MERIDIAN, TOWN OF DELAVAN, WALWORTH COUNTY, WISCONSIN

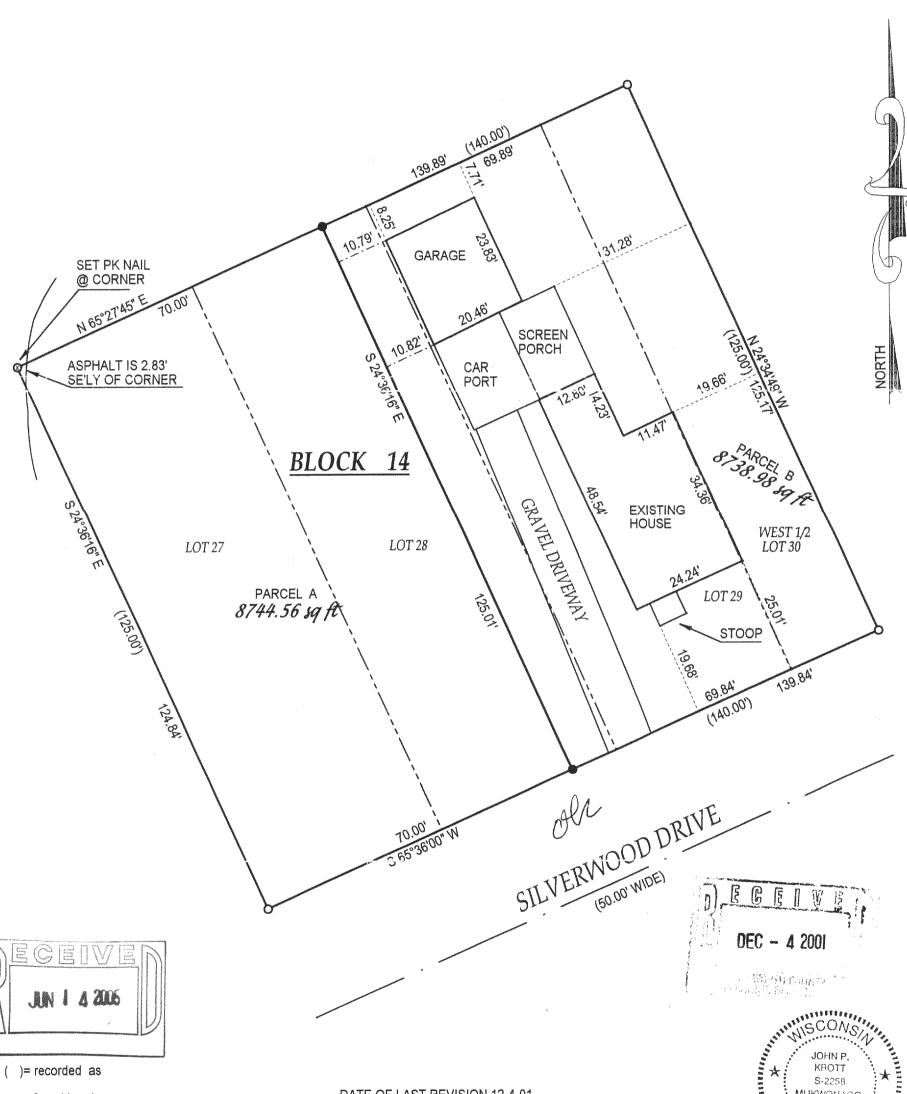

= found iron bar

= found iron pipe

= set iron pipe

= set iron bar

SCALE 1" = 20'

JOB #01-222

TAX ID #2-16-FDLV-65

DATE OF LAST REVISION 12-4-01

COMPARE LEGAL DESCRIPTION ABOVE AND DRAWING WITH DEED. FOR BUILDING RESTRICTIONS AND EASEMENTS NOT SHOWN, REFER TO DEED, ABSTRACT SOURCES AND LOCAL MUNICIPAL CODES. NOTIFY THE SURVEYOR IMMEDIATELY OF ANY DISCREPANCY.

"I hereby certify that I have surveyed the above described property and that the above map is a true representation thereof and shows the size and location of all visible structures, apparent easements and encroachments

This survey is made for the present owners of the property, and those who purchase, mortgage, or guarantee the title thereto, within one year from the date hereof.

DATED THIS TH, DAY OF

<u>JUNE</u> 20 01



JOHN KROTT S - 2258 Wisconsin Registered Land Surveyor (original if signed in red)