


ABELL
SURVEYING & MAPPING

1140 SEQUOIA STREET • DELAVAN, WISCONSIN 53115
262-728-6737

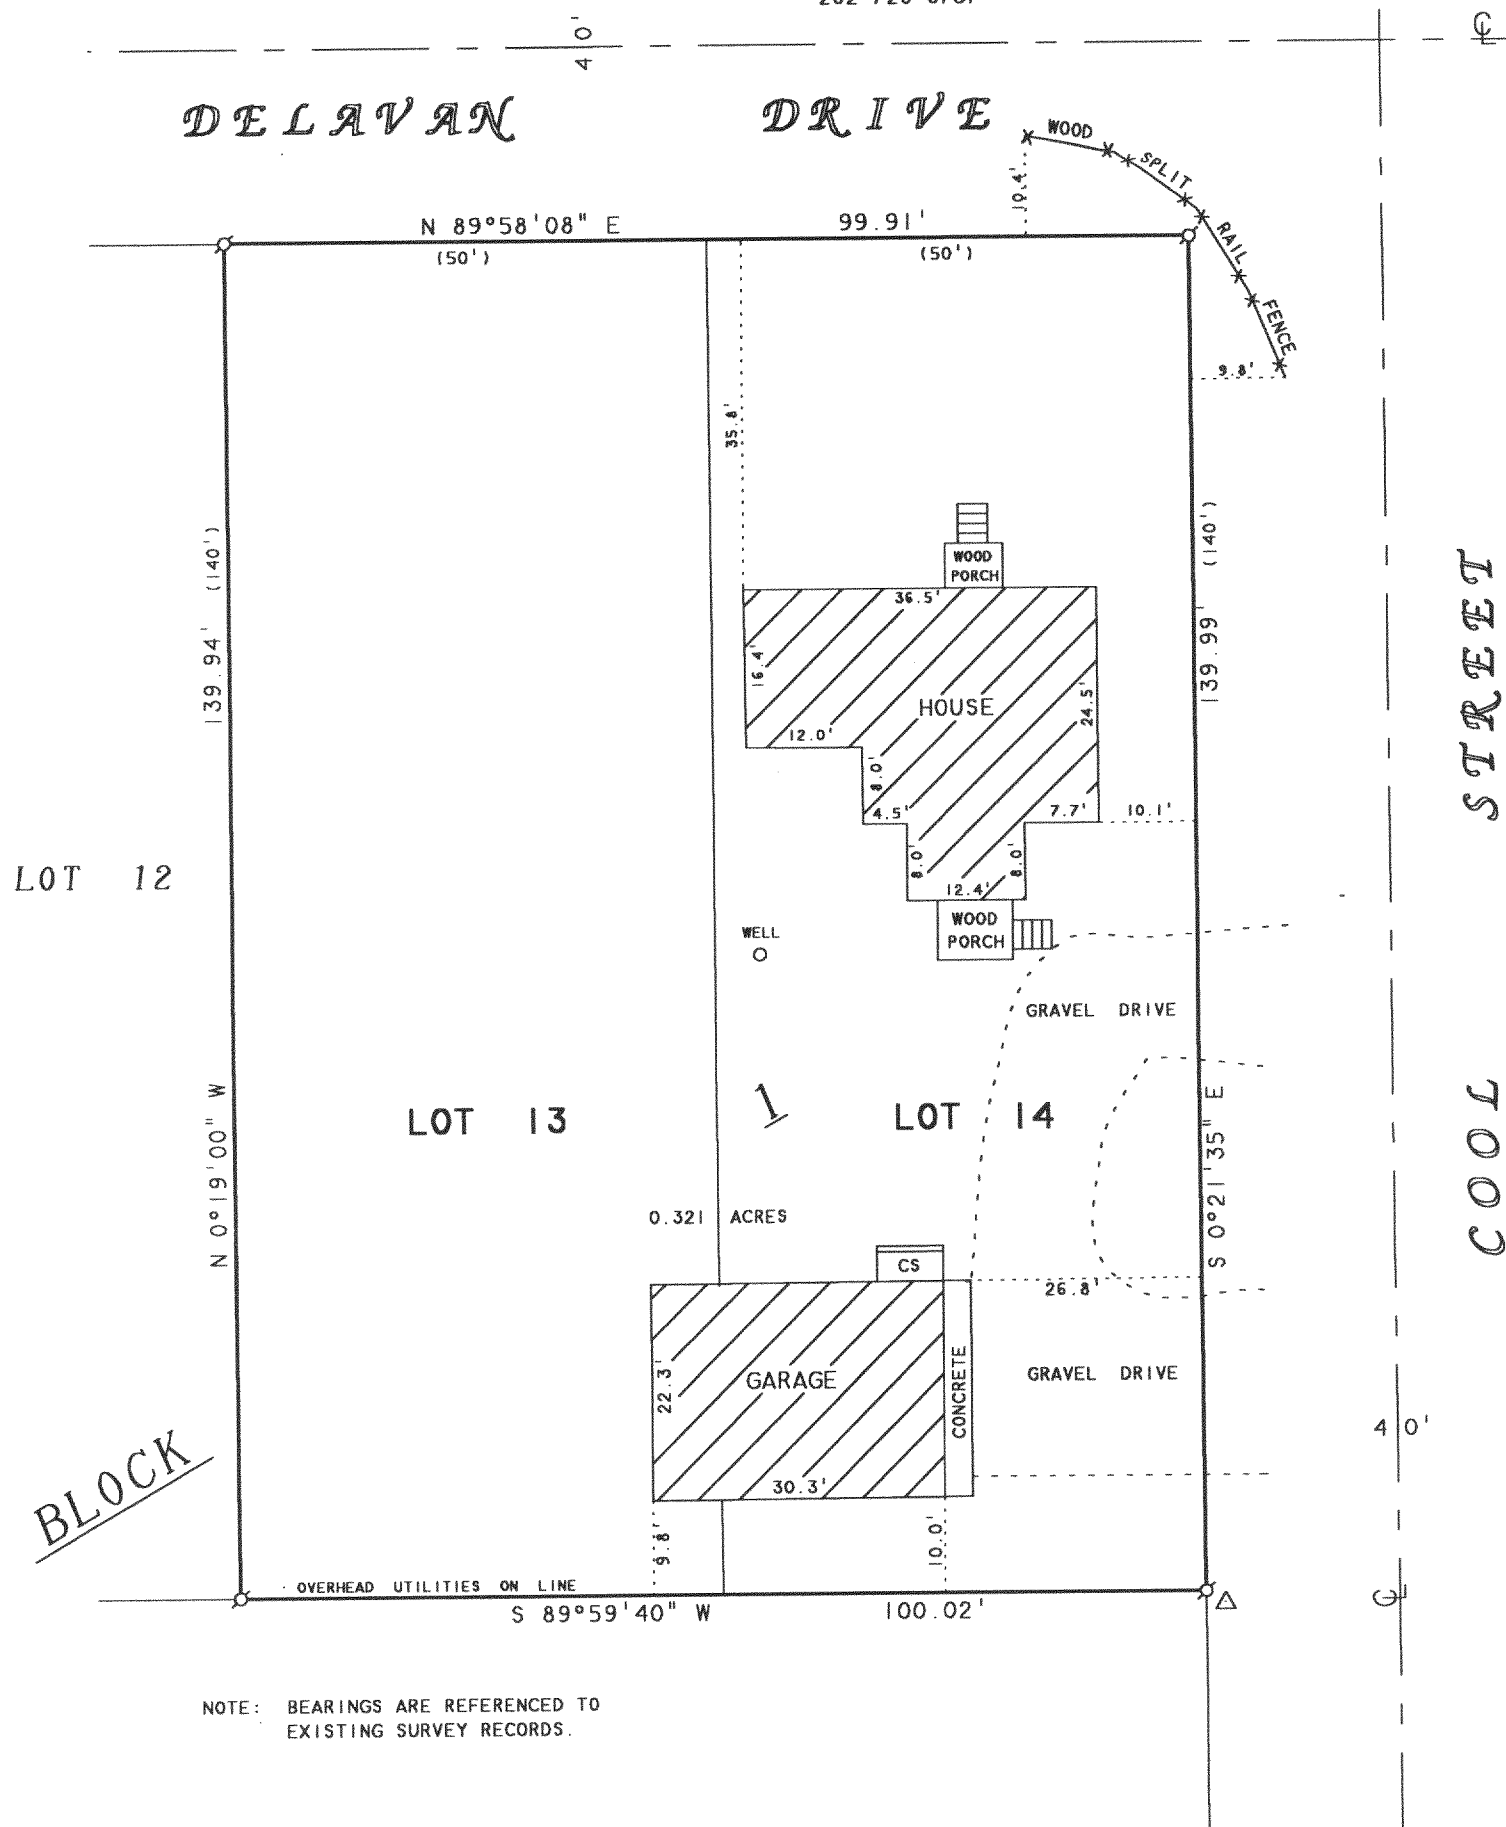

ORDERED BY: CENTURY 21-SKANDIA REALTY
822 E. GENEVA STREET
DELAVAN, WI 53115

PLAT OF SURVEY OF

LOTS 13 AND 14, BLOCK 1, INLET OAKS SUBDIVISION NO. 4,
LOCATED IN T2N.R16E, WALWORTH COUNTY, WISCONSIN.

N



SCALE 1"=20'

LEGEND

- - IRON PIPE FOUND
- △ - UTILITY POLE
- CS - CONCRETE STOOP
- () - RECORDED AS

REVISED DATE: JULY 23, 2001
REVISED TO SHOW GARAGE UNDER
CONSTRUCTION

REVISED DATE: MAY 8, 2001
REVISED TO SHOW PROPOSED GARAGE
LOCATION

ORDERED BY: REUBEN GOSEWISCH
501 DELAVAN DRIVE
DELAVAN, WI 53115

REVISED AND RECERTIFIED MAY 5, 2005
ORDERED BY: KEEFE REAL ESTATE
980 N. WISCONSIN ST.
ELKHORN, WI 53121

I HEREBY CERTIFY THAT I HAVE SURVEYED THE ABOVE DESCRIBED PROPERTY AND THAT THE ABOVE MAP IS A TRUE REPRESENTATION THEREOF AND SHOWS THE SIZE AND LOCATION OF THE PROPERTY, ITS EXTERIOR BOUNDARIES, THE LOCATION OF ALL VISIBLE STRUCTURES AND DIMENSIONS OF ALL PRINCIPAL BUILDINGS THEREON, BOUNDARY FENCES, APPARENT EASEMENTS, ROADWAYS AND VISIBLE ENCROACHMENTS, IF ANY, TO THE BEST OF MY KNOWLEDGE AND BELIEF.

THIS SURVEY IS MADE FOR THE USE OF THE PRESENT OWNERS OF THE PROPERTY, AND ALSO THOSE WHO PURCHASE, MORTGAGE, OR GUARANTEE THE TITLE THERETO WITHIN ONE (1) YEAR FROM DATE HEREON.

DAVID F. ABELL
WISCONSIN REGISTERED LAND SURVEYOR, S-1596

April 14, 1999

DATE: April 14, 1999
NOTE: THIS IS NOT A CERTIFIED COPY UNLESS SEALED.

