


2K-4549

FA 616-2

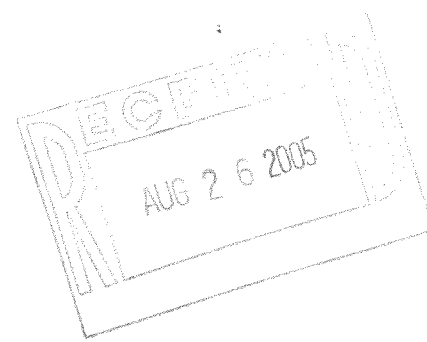

PLAT OF SURVEY OF

I HEREBY CERTIFY THAT I HAVE SURVEYED THE ABOVE DESCRIBED PROPERTY AND THAT THE ABOVE MAP IS A TRUE REPRESENTATION THEREOF AND SHOWS THE SIZE AND LOCATION OF THE PROPERTY, ITS EXTERIOR BOUNDARIES, THE LOCATION OF ALL VISIBLE STRUCTURES AND DIMENSIONS OF ALL PRINCIPAL BUILDINGS THEREON, BOUNDARY FENCES, APPARENT EASEMENTS, ROADWAYS AND VISIBLE ENCROACHMENTS, IF ANY, TO THE BEST OF MY KNOWLEDGE AND BELIEF.

FROM DATE HEREON.

David F. Phillips

DATE July 7, 2005

ORDERED BY: BRIAN SCHUK
WASSEL LAW OFFICE
1034 ANN STREET
DELAVER, WI 53115



LEGEND

○ - IRON PIPE FOUND
 △ - UTILITY POLE
 □ - UTILITY PED
 ——— OVERHEAD UTILITY LINES
 *** - WIRE FENCE
 ——— WOOD BOARD FENCE
 ——— WOOD RAIL FENCE
 () - RECORDED AS