


1140 SEQUOIA STREET • DELAVAN, WISCONSIN 53115
262-728-6737

ASSEMBLY LANE

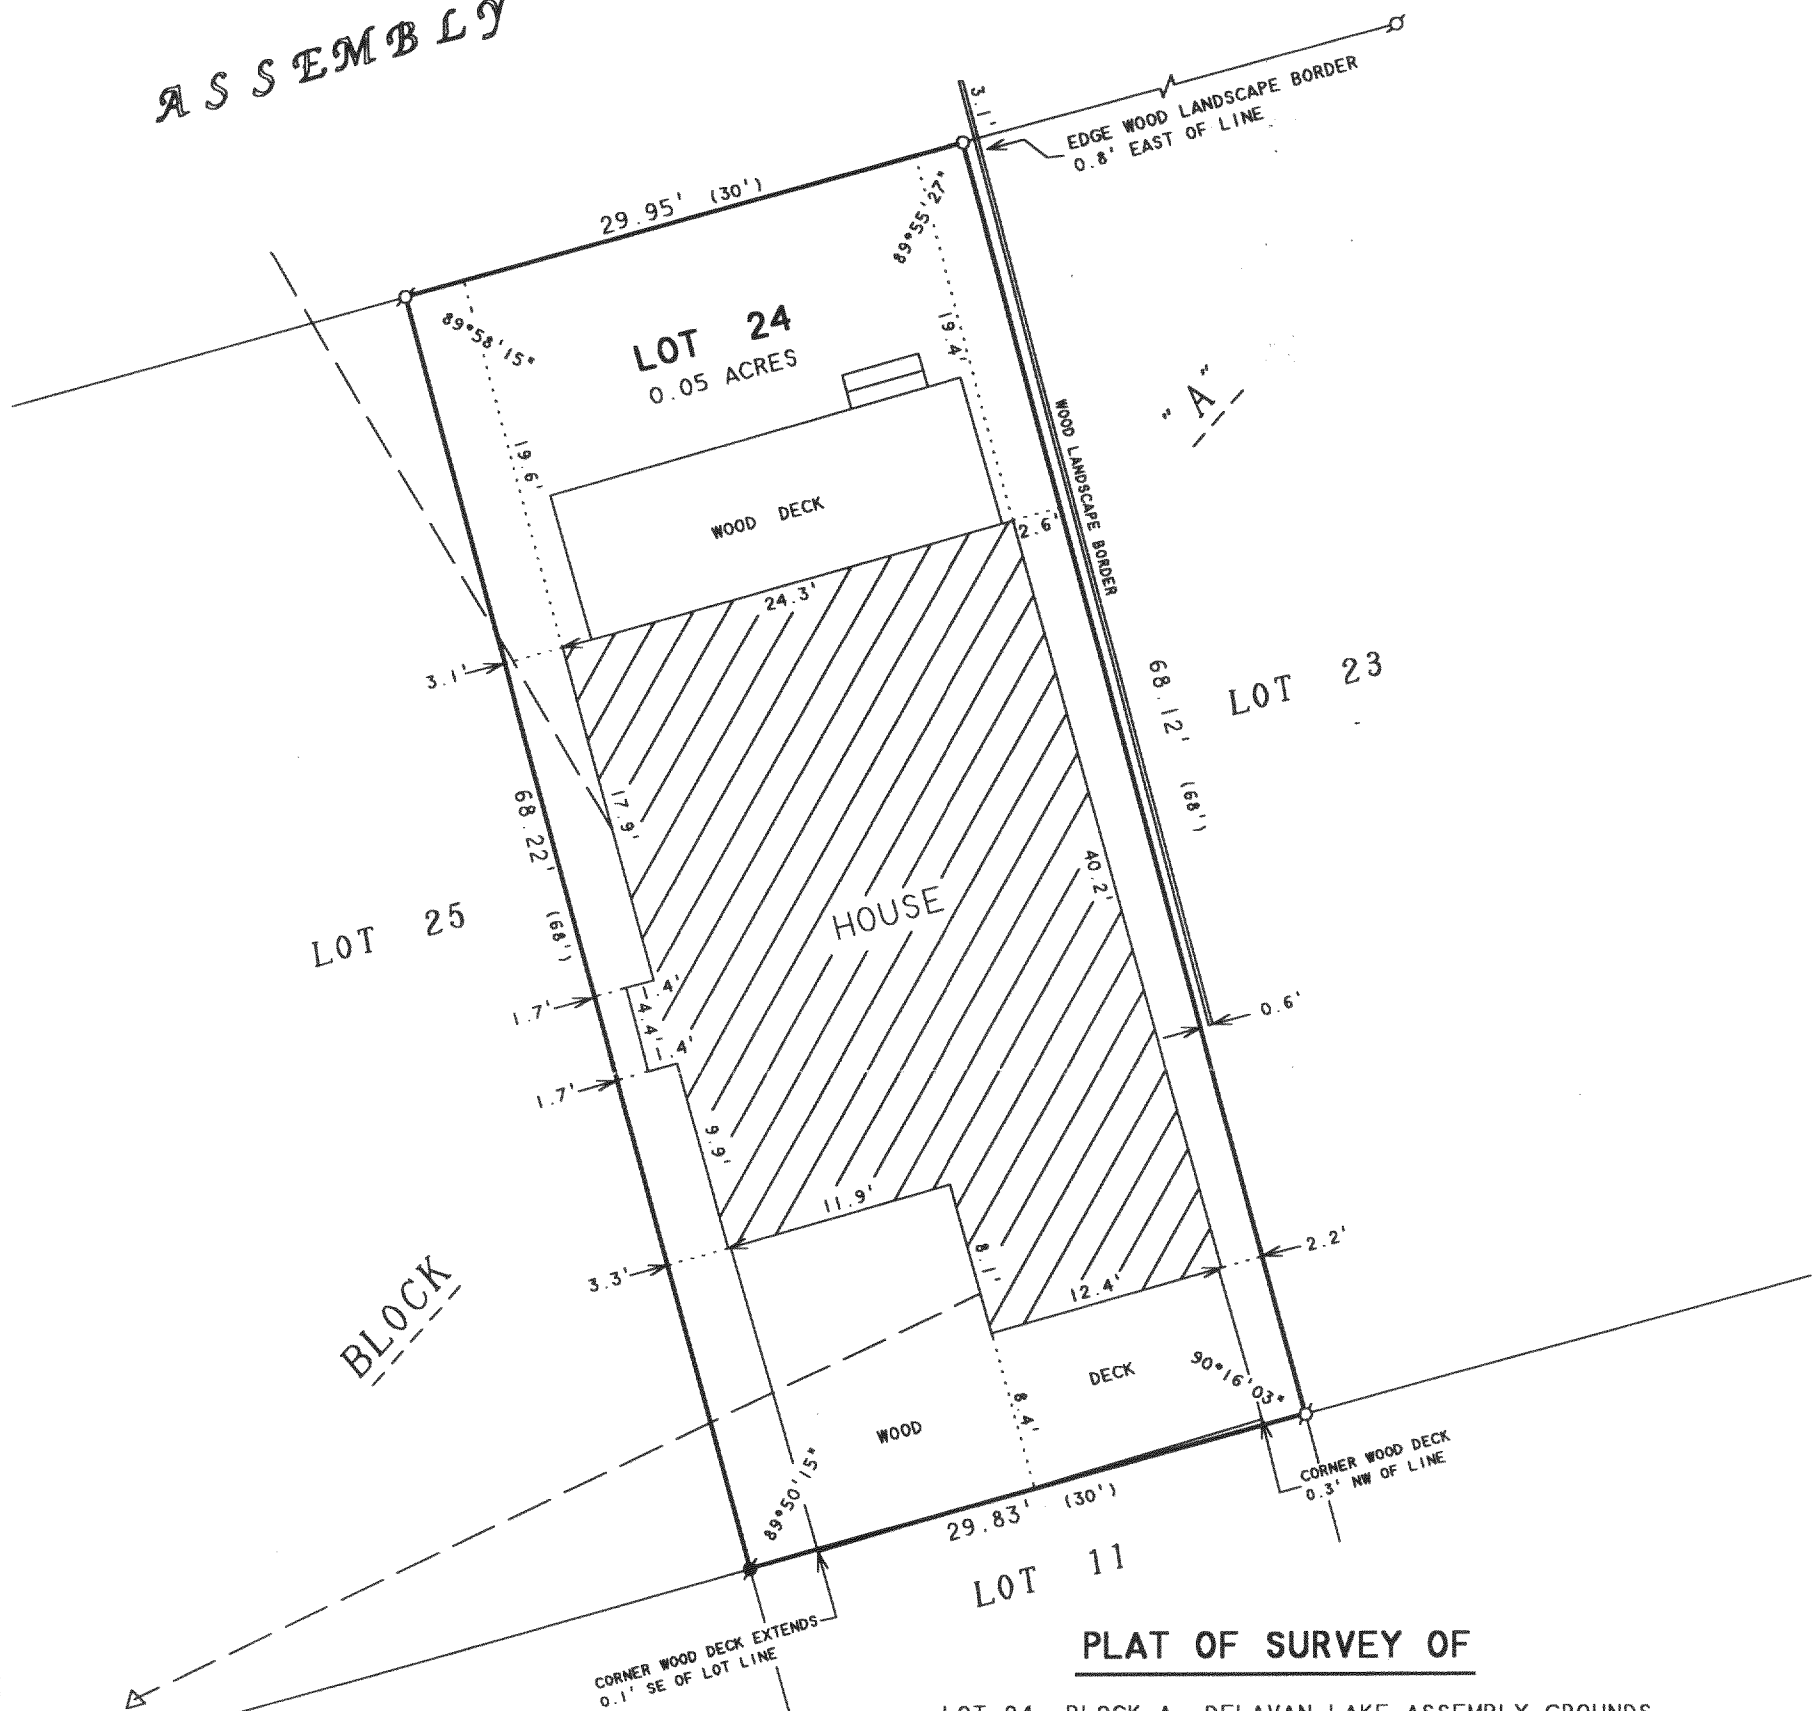

LOT 24, BLOCK A, DELAVAN LAKE ASSEMBLY GROUNDS,
LOCATED IN T2N,R16E, WALWORTH COUNTY, WISCONSIN.

ORDERED BY: JAMES POTTER
200 APPLEBEE STREET
SUITE 201
BARRINGTON, IL 60010

THIS SURVEY IS MADE FOR THE USE OF THE PRESENT OWNERS OF THE PROPERTY, AND ALSO THOSE WHO PURCHASE, MORTGAGE, OR GUARANTEE THE TITLE THERETO WITHIN ONE (1) YEAR FROM DATE HEREON.

* Daniel F. Phil

DAVID F. ABELL
WISCONSIN REGISTERED LAND SURVEYOR. S-1596

June 29, 2005

DATE _____ JOB NUMBER - 05077
NOTE: THIS IS NOT A CERTIFIED COPY UNLESS SEALED.

LEGEND

- ♂ - IRON PIPE FOUND
 ○ - IRON PIPE SET
 ● - CONCRETE MONUMENT FOUND
 △ - UTILITY POLE
 — - OVERHEAD UTILITY LINES
 () - RECORDED AS

FDLA 000191A

216-4053