
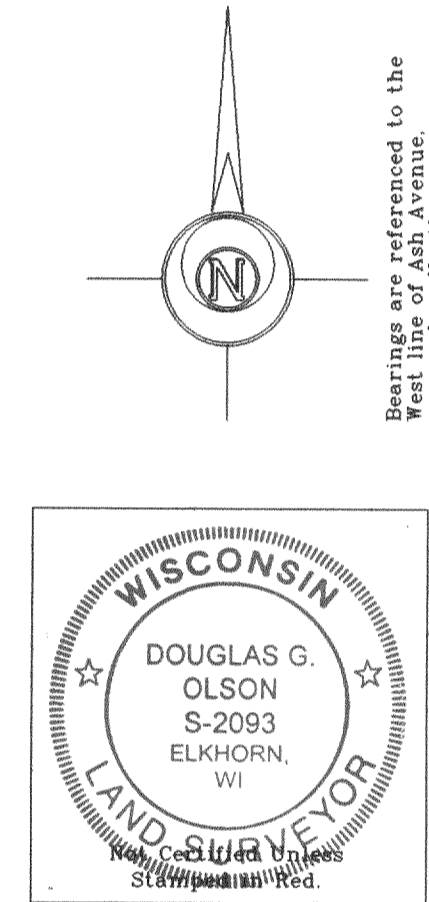


Plat of Survey

of

Lots 334 and 335 of Lake Delavan Highlands,
a subdivision located in the Southeast 1/4 of Section 31, Town 2 North,
Range 16 East, Town of Delavan, Walworth County, Wisconsin.

Surveyed for: **Godfrey, Leibsle, Blackburn & Howarth, S.C.**
354 Seymour Court ** Post Office Box 260
Elkhorn, Wisconsin. 53121

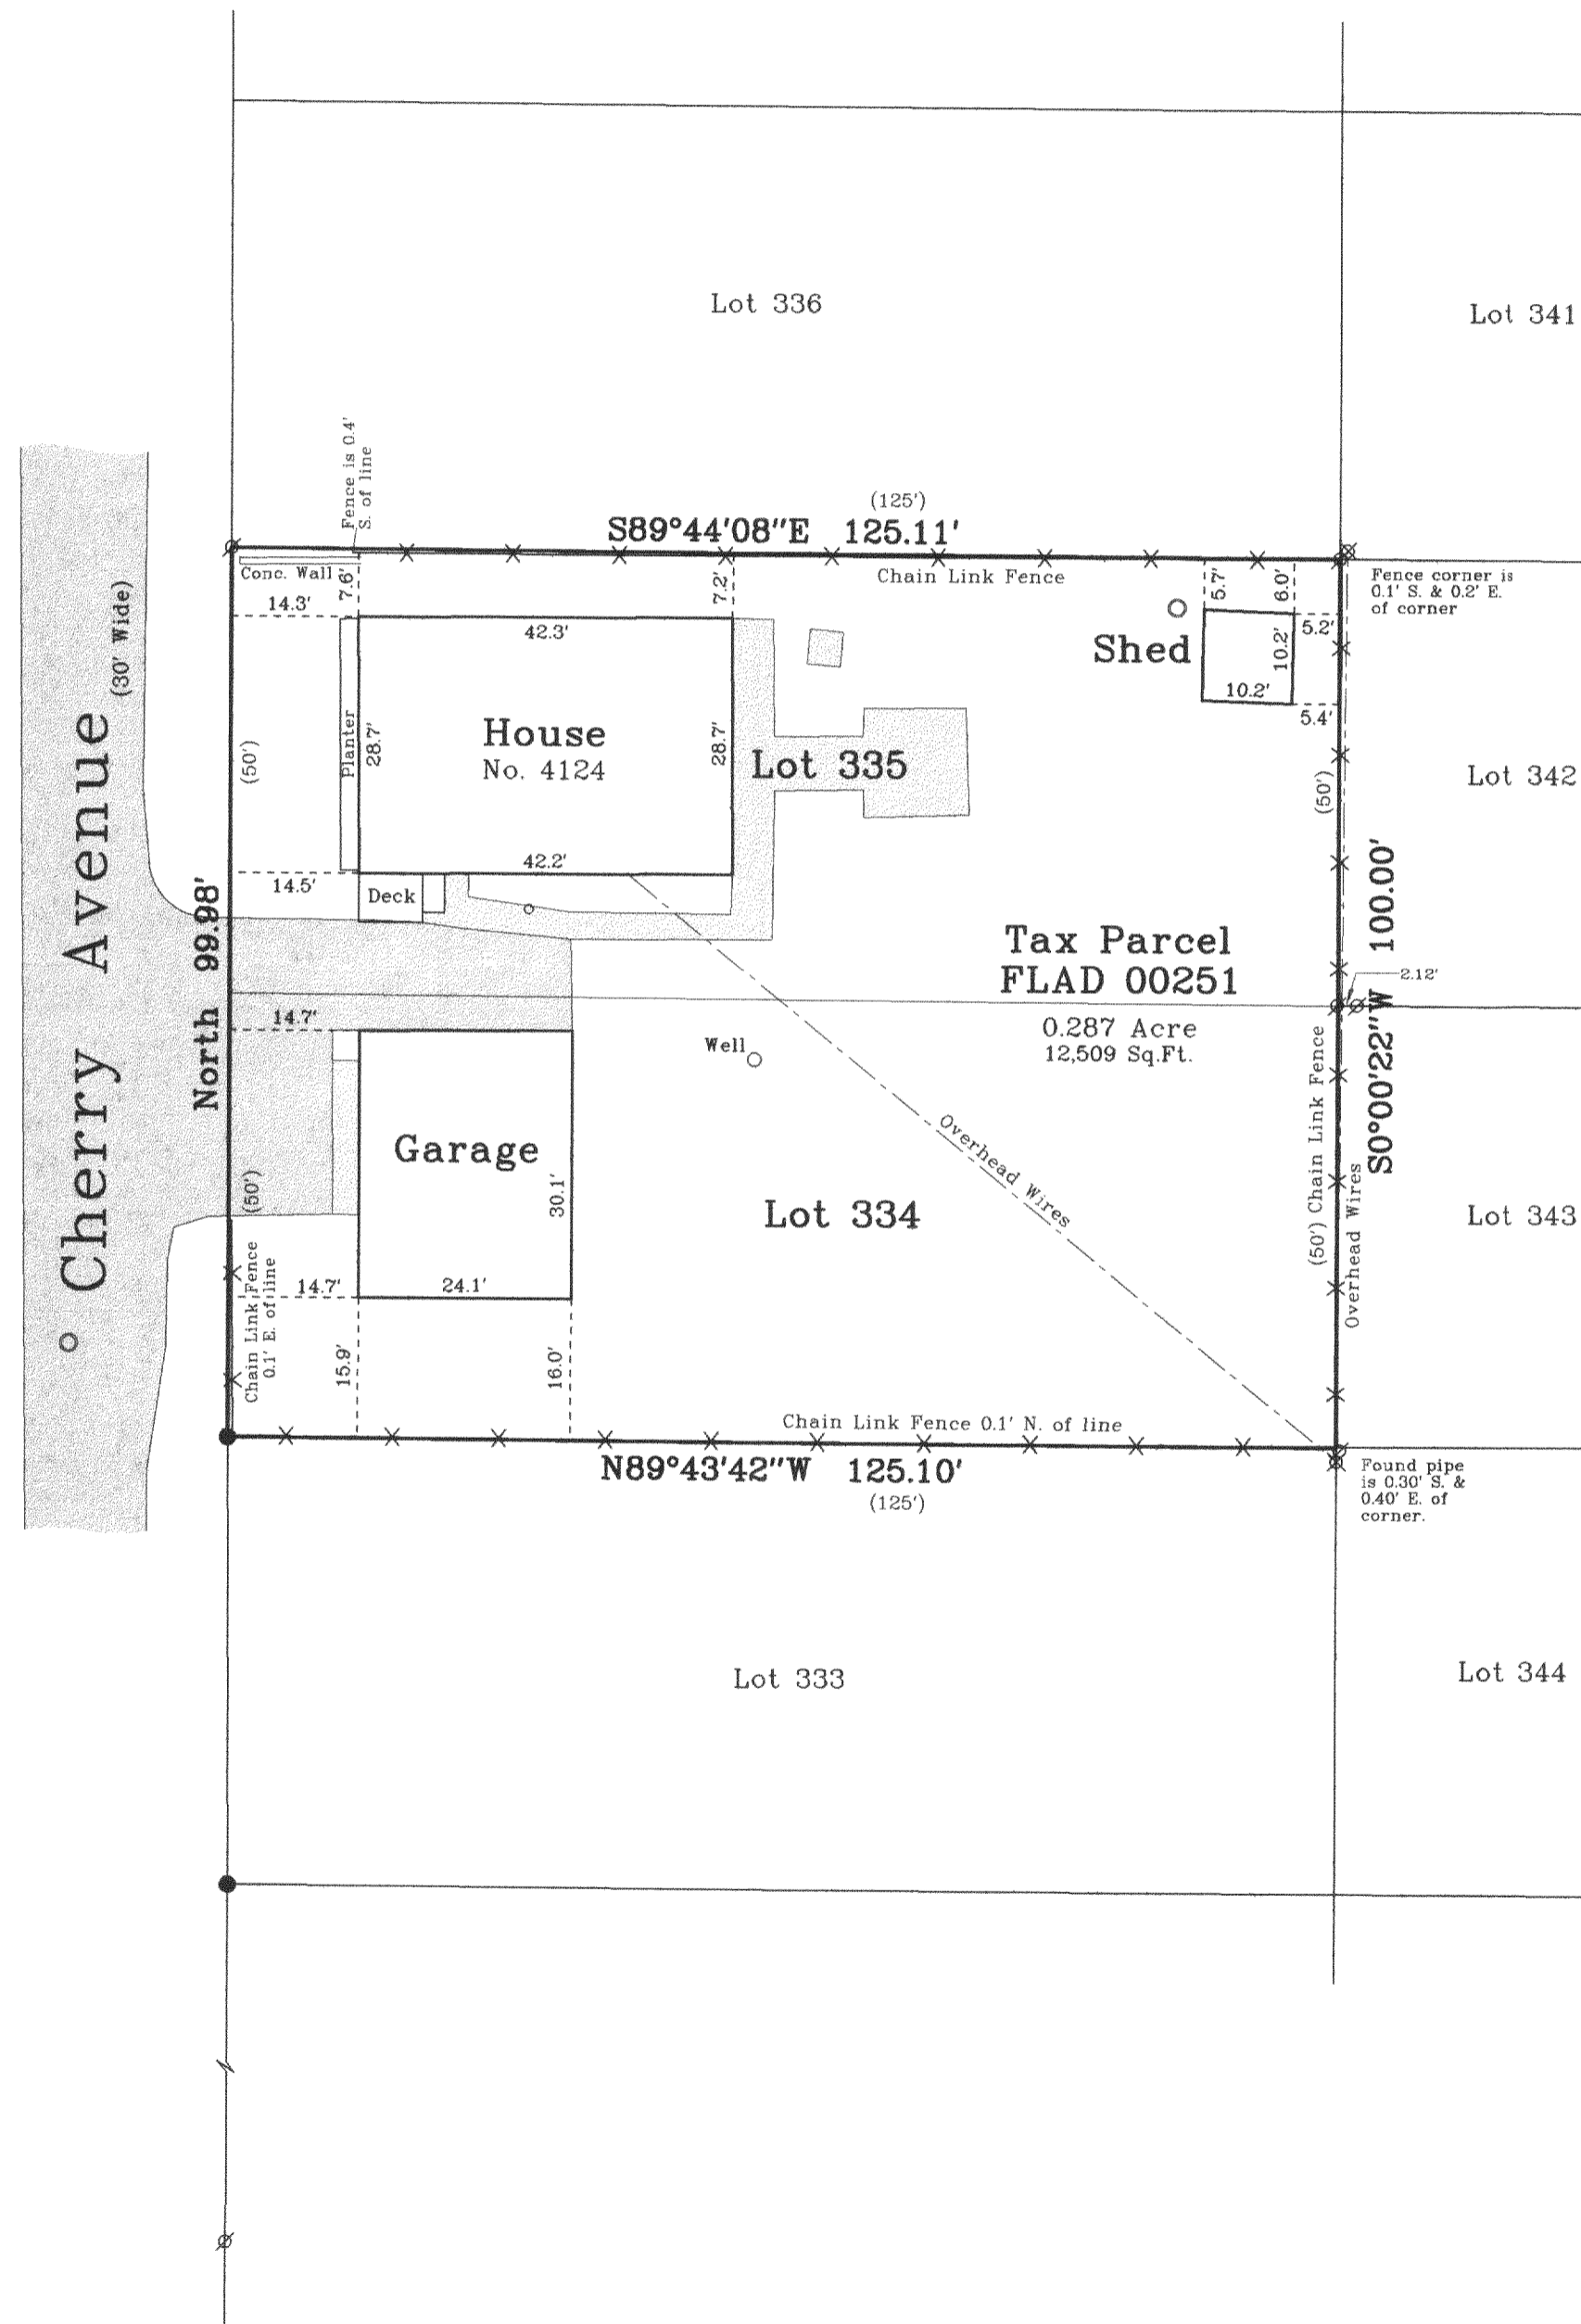

Bearings are referenced to the West line of Ash Avenue, assumed as North.

- Notes: 1) This survey plat is not certified unless signed and sealed in red ink.
2) This survey is subject to Wisconsin lien laws. This Plat of Survey is the notice of intent to file lien. Lien waiver required.


Copyright © 2005 by Jensen & Olson Land Surveying, LLC.

All rights reserved. No part of this survey plat may be reproduced or transmitted in any form by any means - graphic, electronic, or mechanical, including photocopying, tracing, or information storage and retrieval systems - without permission in writing from Douglas G. Olson, Jensen & Olson Land Surveying, LLC.

I hereby certify that I have surveyed the above described property and the map hereon is correct to the best of my professional knowledge and belief and shows the size and location of the property, its exterior boundaries, the location and dimensions of all visible structures thereon, boundary fences, apparent easements and roadways and visible encroachments, if any.
This survey is made for the exclusive use of the present owners of property, and also those who purchase, mortgage or guarantee title thereto, within one year from the date hereof.

Douglas G. Olson
Wisconsin Registered Land Surveyor - 2093

Survey Date: June 6, 2005.
Revisions:

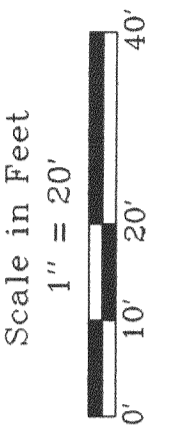

Jensen & Olson Land Surveying, LLC
45 South Wisconsin Street P.O. Box 322
Elkhorn, Wisconsin. 53121
Telephone (262) 723-3434
Facsimile (262) 723-8044

- Legend
- Found Iron Pipe 3/4" dia.
 - Found Iron Rod
 - Recorded Information
 - Utility Pole
 - Utility Pedestal
 - Manhole or Concrete Cover
 - Asphalt Surface
 - Concrete Surface

Sheet 1 of 1 Sheets
Job Reference Number
2005.086

2005.086

206-4890

FLAD 08951