## LAND-MARK SURVEYING Mark L. Miritz

Wisconsin Registered Land Surveyor S-2582

N9330 Knuteson Drive Whitewater, WI 53190 Phone:(262)495-3284 FAX: (262) 495-8421 LAND-MARKSURVEYING.COM

PLAT OF SURVEY

N0/ 1:7 8MF-

LOTS 14 AND 15, BLOCK 18, DELAVAN LAKE **VIEW CREST SUBDIVISION, LOCATED IN SECTION** 31, TOWN 2 NORTH, RANGE 16 EAST, DELAVAN TOWNSHIP, WALWORTH COUNTY, WISCONSIN.

**ORDERED BY: SCHAUDER HOMES** 


6326 1ST AVE.

LAKE GENEVA, WI. 53147

(262) 248-1088

**OWNER: JACK MELZER** 

4408 HIGHLAND DRIVE

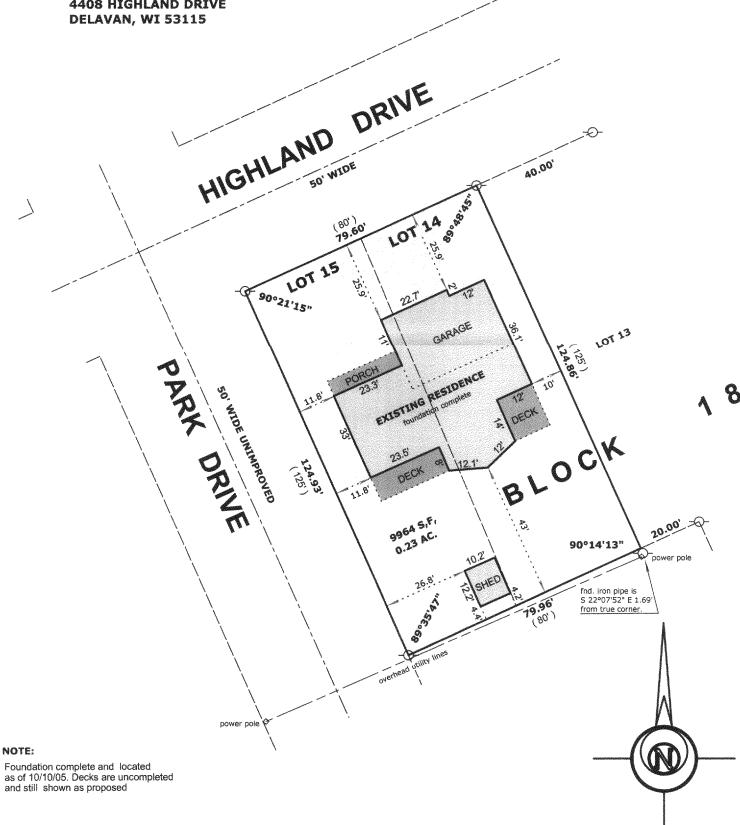

## LEGEND

**FOUND IRON PIPE** Ø FOUND IRON ROD

FOUND COUNTY MONUMENT  $\boxtimes$ 

OFFSET STAKE CHISEL CUT IN CONCRETE

SET IRON ROD, 24" LONG, WEIGHING 1.5 LBS./LINEAL FT., 3/4" DIA.

RECORDED AS DIMENSION **EXISTING FENCE** 

REVISED 10/10/05 FOUNDATION LOCATED "AS BUILT"

annamananana ana Wiecons/

MIRITZ

S-2582

WI

SUR

Management of the Control of the Con

WHITEWATER

## SCALE: 1'' = 30 FEET

"I hereby certify that the above described property has been surveyed by me or under my direction and that the above map is a true representation thereof and shows the size and location of the property, its exterior boundaries, the location of all visible structures and dimensions of all principal buildings thereon, boundary fences, apparent easements, roadways and visible encroachments, if any."

"This survey is made for the use of the present owners of the property, and also those who purchase, mortgage, or guarantee the title thereto within one year from date

Vanh MARK L. MIRITZ WISCONSIN REGISTERED **LAND SURVEYOR S-2582** 

DATE:\_\_JULY 26, 2005 JOB NO. 05.715