

ABELL SURVEYING & MAPPING

1140 SEQUOIA STREET . DELAVAN, WISCONSIN 53115 262-728-6737

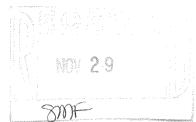

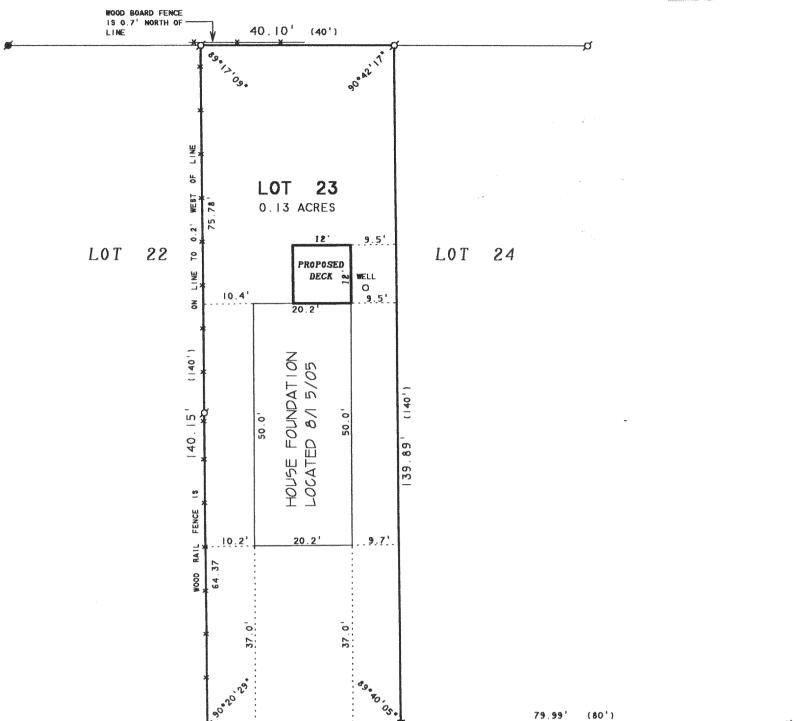

20

PLAT OF SURVEY OF

40.07

MAPLE

(40')

LOT 23 OF KUMHAAR'S ADDITION TO RAVENSWOOD. LOCATED IN T2N.RIGE. WALWORTH COUNTY. WISCONSIN

ORDERED BY: TOM WOLF

3901 N. LINCOLN CHICAGO, WI 60613

DRIVE

SCALE | " = 20'

LEGEND

Ø - IRON PIPE FOUND Ø - IRON ROD FOUND

- SQUARE IRON ROD FOUND - WOOD FENCE

() - RECORDED AS

I HEREBY CERTIFY THAT I HAVE SURVEYED THE ABOVE DESCRIBED PROPERTY AND THAT THE ABOVE MAP IS A TRUE REPRESENTATION THEREOF AND SHOWS THE SIZE AND LOCATION OF THE PROPERTY, ITS EXTERIOR BOUNDARIES, THE LOCATION OF ALL VISIBLE STRUCTURES AND DIMENSIONS OF ALL PRINCIPAL BUILDINGS THEREON, BOUNDARY FENCES, APPARENT EASEMENTS, ROADWAYS AND VISIBLE ENCROACHMENTS, IF ANY, TO THE BEST OF MY

THIS SURVEY IS MADE FOR THE USE OF THE PRESENT OWNERS OF THE PROPERTY, AND ALSO THOSE WHO PURCHASE, MORTGAGE, OR GUARANTEE THE TITLE THERETO WITHIN ONE (I) YEAR FROM DATE HEREON.

KNOWLEDGE AND BELIEF

DAVID F. ABELL WISCONSIN REGISTERED LAND SURVEYOR, S-1596

April 22, 2005

DATE JOB NUMBER - 05043B NOTE: THIS IS NOT A CERTIFIED COPY UNLESS SEALED.

REVISED: JUNE 23, 2005 TO SHOW PROPOSED NEW FOUNDATION, ADDITION, DECK AND BASEMENT ENTRY

REVISED DATE: AUGUST 17, 2005 REVISED TO SHOW LOCATION OF FOUNDATION AND LOCATION OF PROPOSED DECK.

ORDERED BY: ANDY NELSON

732 S. CRESANT AVE. PARK RIDGE. IL 60068