

ABELL
SURVEYING & MAPPING
1140 SEQUOIA STREET • DELAVAN, WISCONSIN 53115
262-728-6737


NOTE: THE 100 YEAR FLOODPLAIN FOR
DELANVAN LAKE IS 928 FEET
LAKE ELEVATION PROVIDED BY
USGS REAL-TIME WATER DATE
FOR DELAVAN LAKE.



SCALE 1"=20'

LEGEND

- - IRON PIPE FOUND
- - SASH WEIGHT FOUND
- - 1" DIA. IRON PIPE SET
- △ - UTILITY POLE
- - OVERHEAD UTILITY LINES
- - GUY WIRE
- ⊗ - STONE PILLAR
- MH ⊕ - MANHOLE COVER
- ⊕ - STORM DRAIN INLET
- CS - CONCRETE STOOP
- BE - BASEMENT ENTRY
- 942.8 - SPOT ELEVATION
- 1 - RECORDED AS

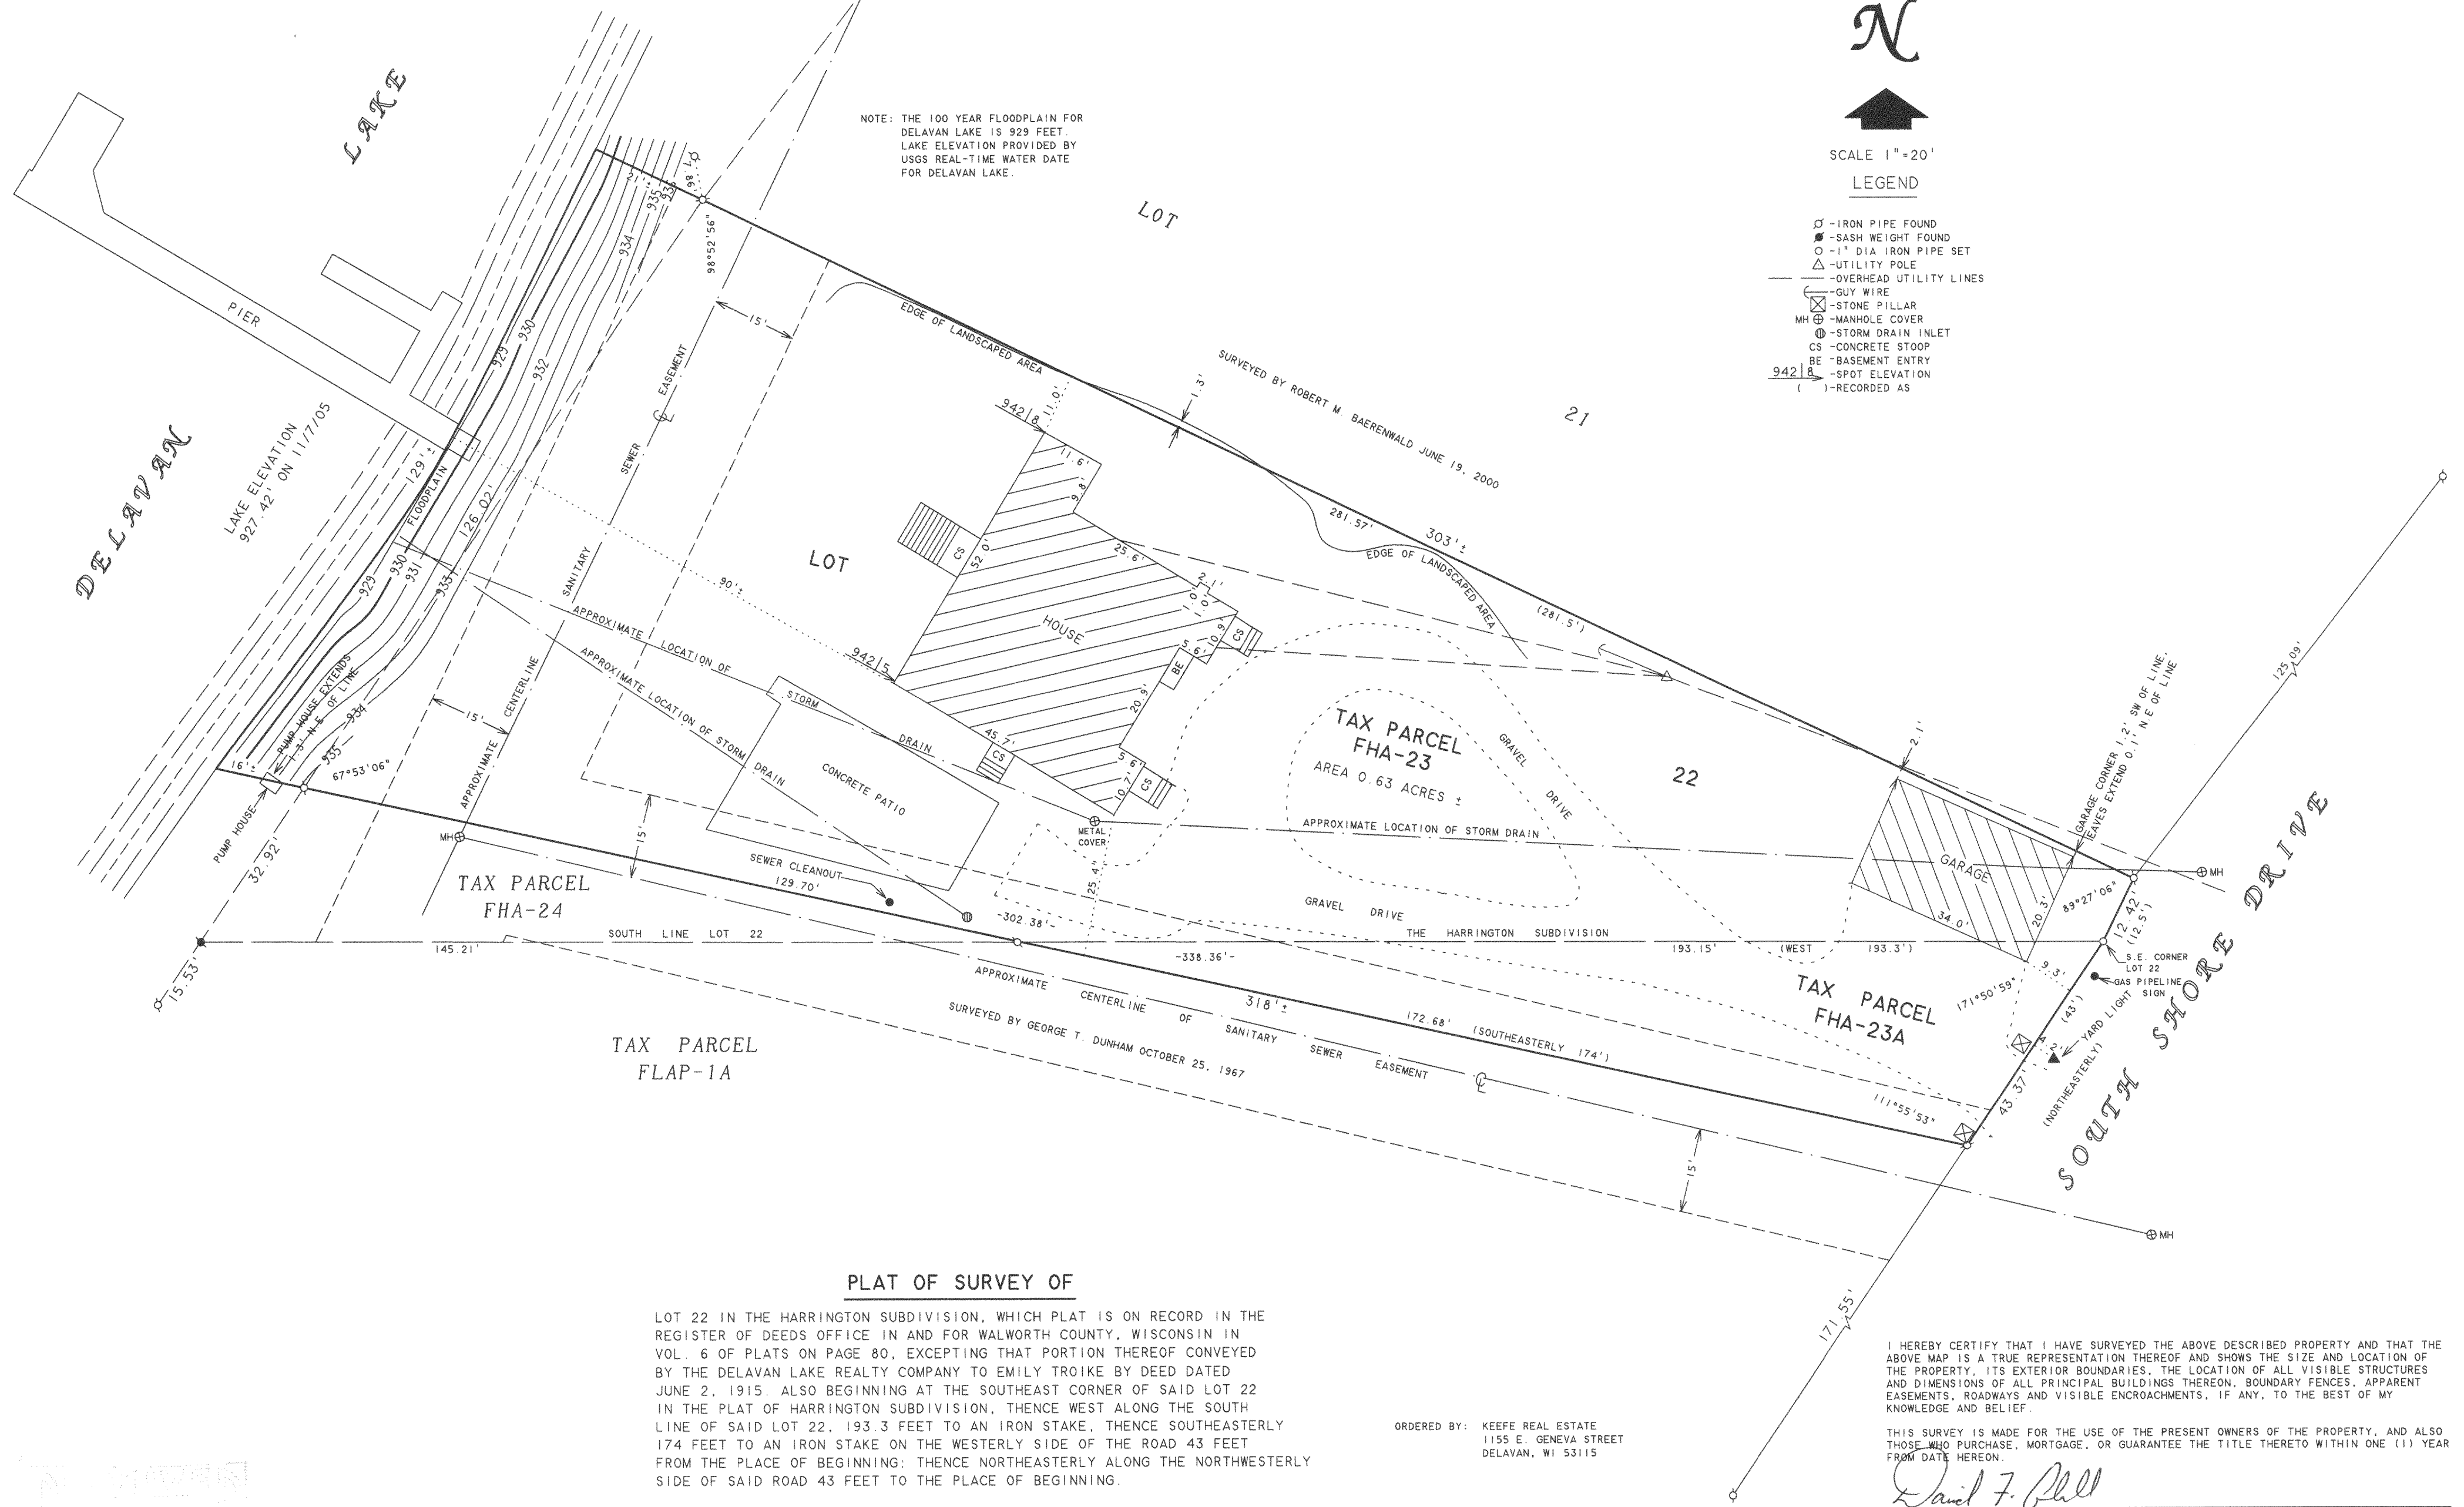

PLAT OF SURVEY OF

LOT 22 IN THE HARRINGTON SUBDIVISION, WHICH PLAT IS ON RECORD IN THE REGISTER OF DEEDS OFFICE IN AND FOR WALWORTH COUNTY, WISCONSIN IN VOL. 6 OF PLATS ON PAGE 80, EXCEPTING THAT PORTION THEREOF CONVEYED BY THE DELAVAN LAKE REALTY COMPANY TO EMILY TROIKE BY DEED DATED JUNE 2, 1915. ALSO BEGINNING AT THE SOUTHEAST CORNER OF SAID LOT 22 IN THE PLAT OF HARRINGTON SUBDIVISION, THENCE WEST ALONG THE SOUTH LINE OF SAID LOT 22, 193.3 FEET TO AN IRON STAKE, THENCE SOUTHEASTERLY 174 FEET TO AN IRON STAKE ON THE WESTERLY SIDE OF THE ROAD 43 FEET FROM THE PLACE OF BEGINNING; THENCE NORTHEASTERLY ALONG THE NORTHWESTERLY SIDE OF SAID ROAD 43 FEET TO THE PLACE OF BEGINNING.

ORDERED BY: KEEFE REAL ESTATE
1155 E. GENEVA STREET
DELANVAN, WI 53115

REVISED DATE: NOVEMBER 7, 2005
REVISED TO SHOW LAKE ELEVATION,
100 YEAR FLOODPLAIN AND SPOT
ELEVATIONS.

ORDERED BY: JIM VONDRASEK
133 S. SPRING AVENUE
LA GRANGE, IL 60525

I HEREBY CERTIFY THAT I HAVE SURVEYED THE ABOVE DESCRIBED PROPERTY AND THAT THE ABOVE MAP IS A TRUE REPRESENTATION THEREOF AND SHOWS THE SIZE AND LOCATION OF THE PROPERTY, ITS EXTERIOR BOUNDARIES, THE LOCATION OF ALL VISIBLE STRUCTURES AND DIMENSIONS OF ALL PRINCIPAL BUILDINGS THEREON, BOUNDARY FENCES, APPARENT EASEMENTS, ROADWAYS AND VISIBLE ENCROACHMENTS, IF ANY, TO THE BEST OF MY KNOWLEDGE AND BELIEF.

THIS SURVEY IS MADE FOR THE USE OF THE PRESENT OWNERS OF THE PROPERTY, AND ALSO THOSE WHO PURCHASE, MORTGAGE, OR GUARANTEE THE TITLE THERETO WITHIN ONE (1) YEAR FROM DATE HEREON.

David F. Abell

DAVID F. ABELL
WISCONSIN REGISTERED LAND SURVEYOR, S-1596

July 12, 2005

DATE: July 12, 2005 JOB NUMBER - 05076A
NOTE: THIS IS NOT A CERTIFIED COPY UNLESS SEALED.

FHA-23 - FHA-23-A

216-4141