


PLAT OF SURVEY AS-BUILT MAPPING

LOT 1 OF CERTIFIED SURVEY MAP NO. 3678
RECORDED IN VOL. 22 ON PG. 52 AS DOC. NO. 596602
LOCATED IN THE SE 1/4 OF THE SE 1/4 OF SECTION 28 AND THE
NE 1/4 OF THE NE 1/4 OF SECTION 33, TOWN 2 NORTH,
RANGE 16 EAST, WALWORTH COUNTY, WISCONSIN


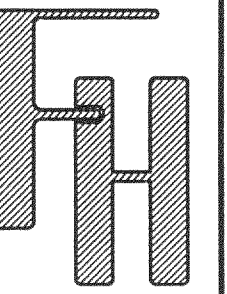


WORK ORDERED BY -
JOHN J. RYAN
1376 R.F.D.
LONG GROVE, IL 60047

FARRIS, HANSEN & ASSOCIATES, INC.
ENGINEERING - ARCHITECTURE - SURVEYING
7 RIDGWAY COURT P.O. BOX 437
ELKHORN, WISCONSIN 53121
OFFICE: (262) 723-2098 FAX: (262) 723-5886

REVISIONS
07/07/2005
SITE, GRADING,
DRAINAGE, AND EROSION
CONTROL PLAN
08/24/2005
MISC. REVISIONS TO
RETAINMENT WALL
09/19/2005
REMOVE POOL & SLIDE
PROPOSED RESIDENCE
TO LAKE
12/01/2005
TO SHOW SIZE AND
LOCATION OF AS-BUILT
FOUNDATION

PROJECT NO.
5982.01
DATE
11/11/03
SHEET NO.
1 OF 1

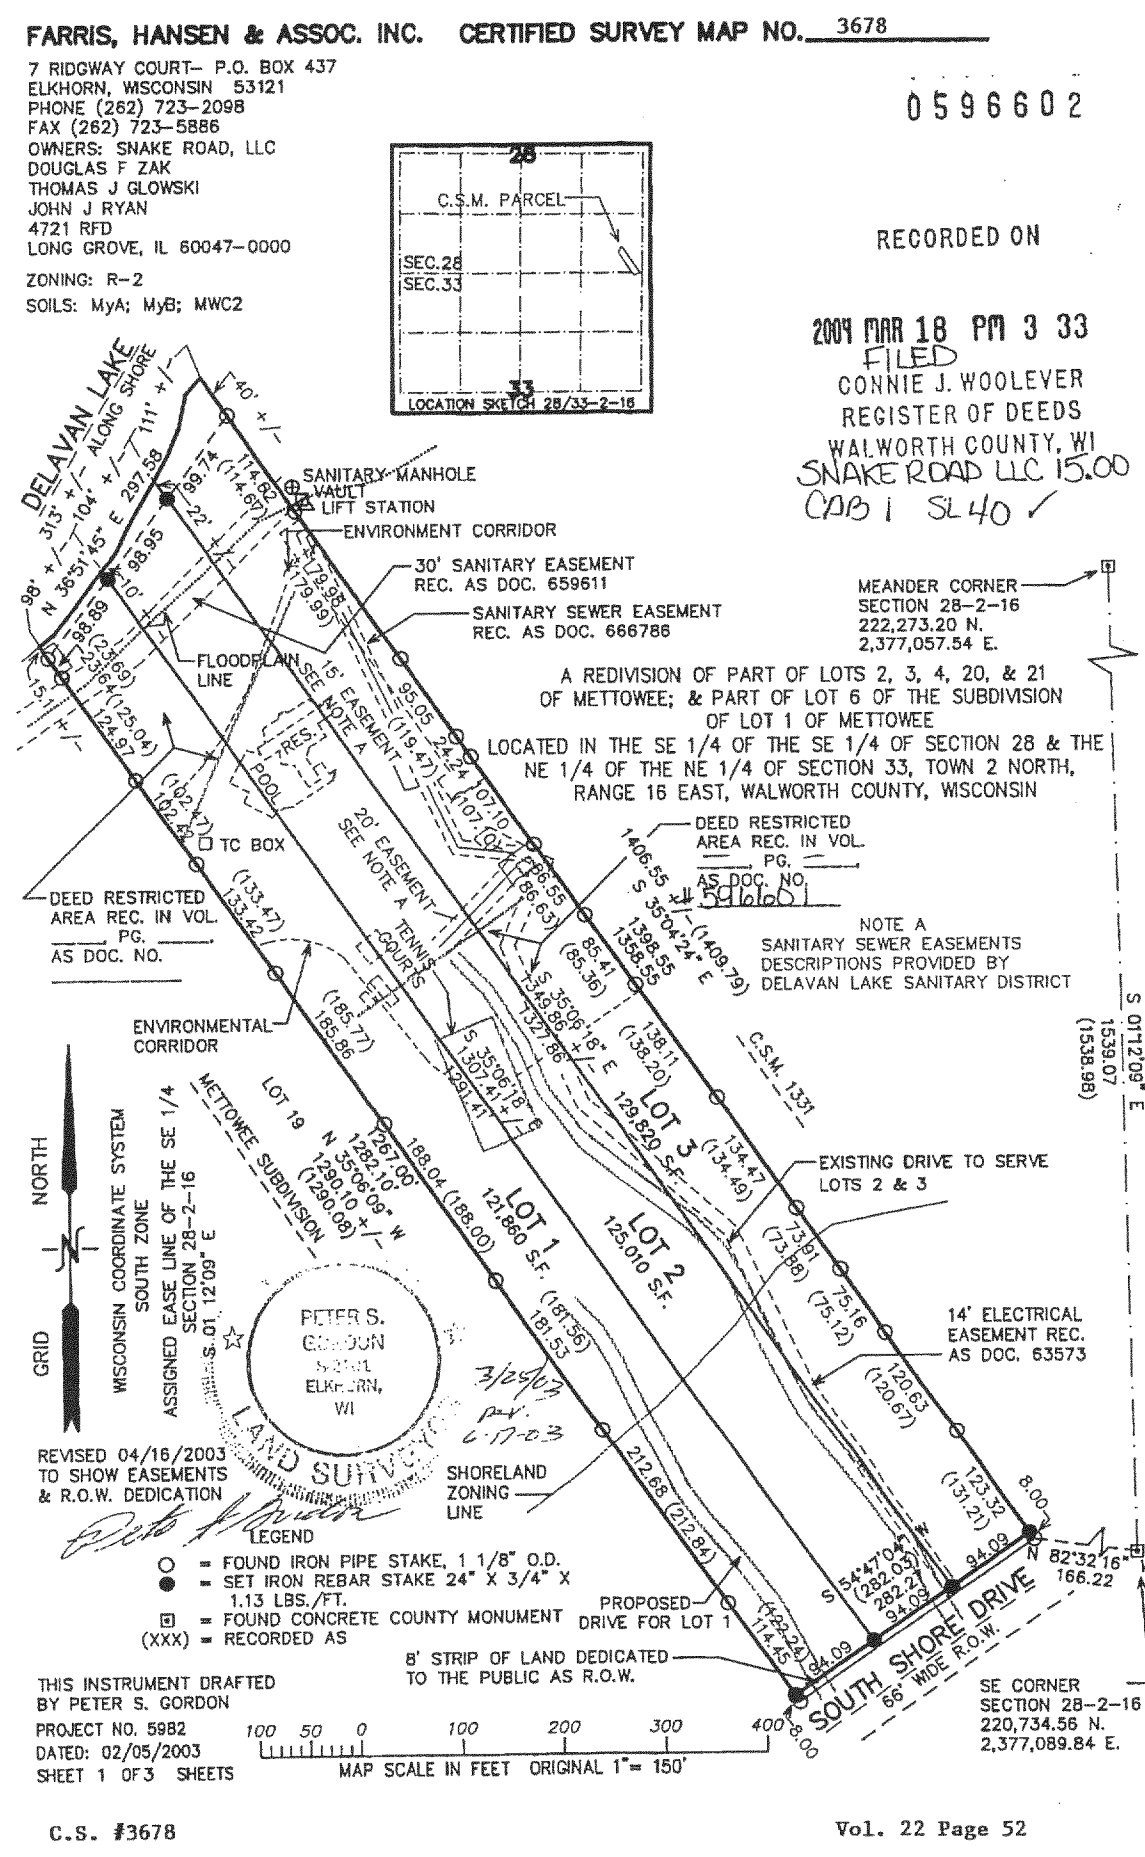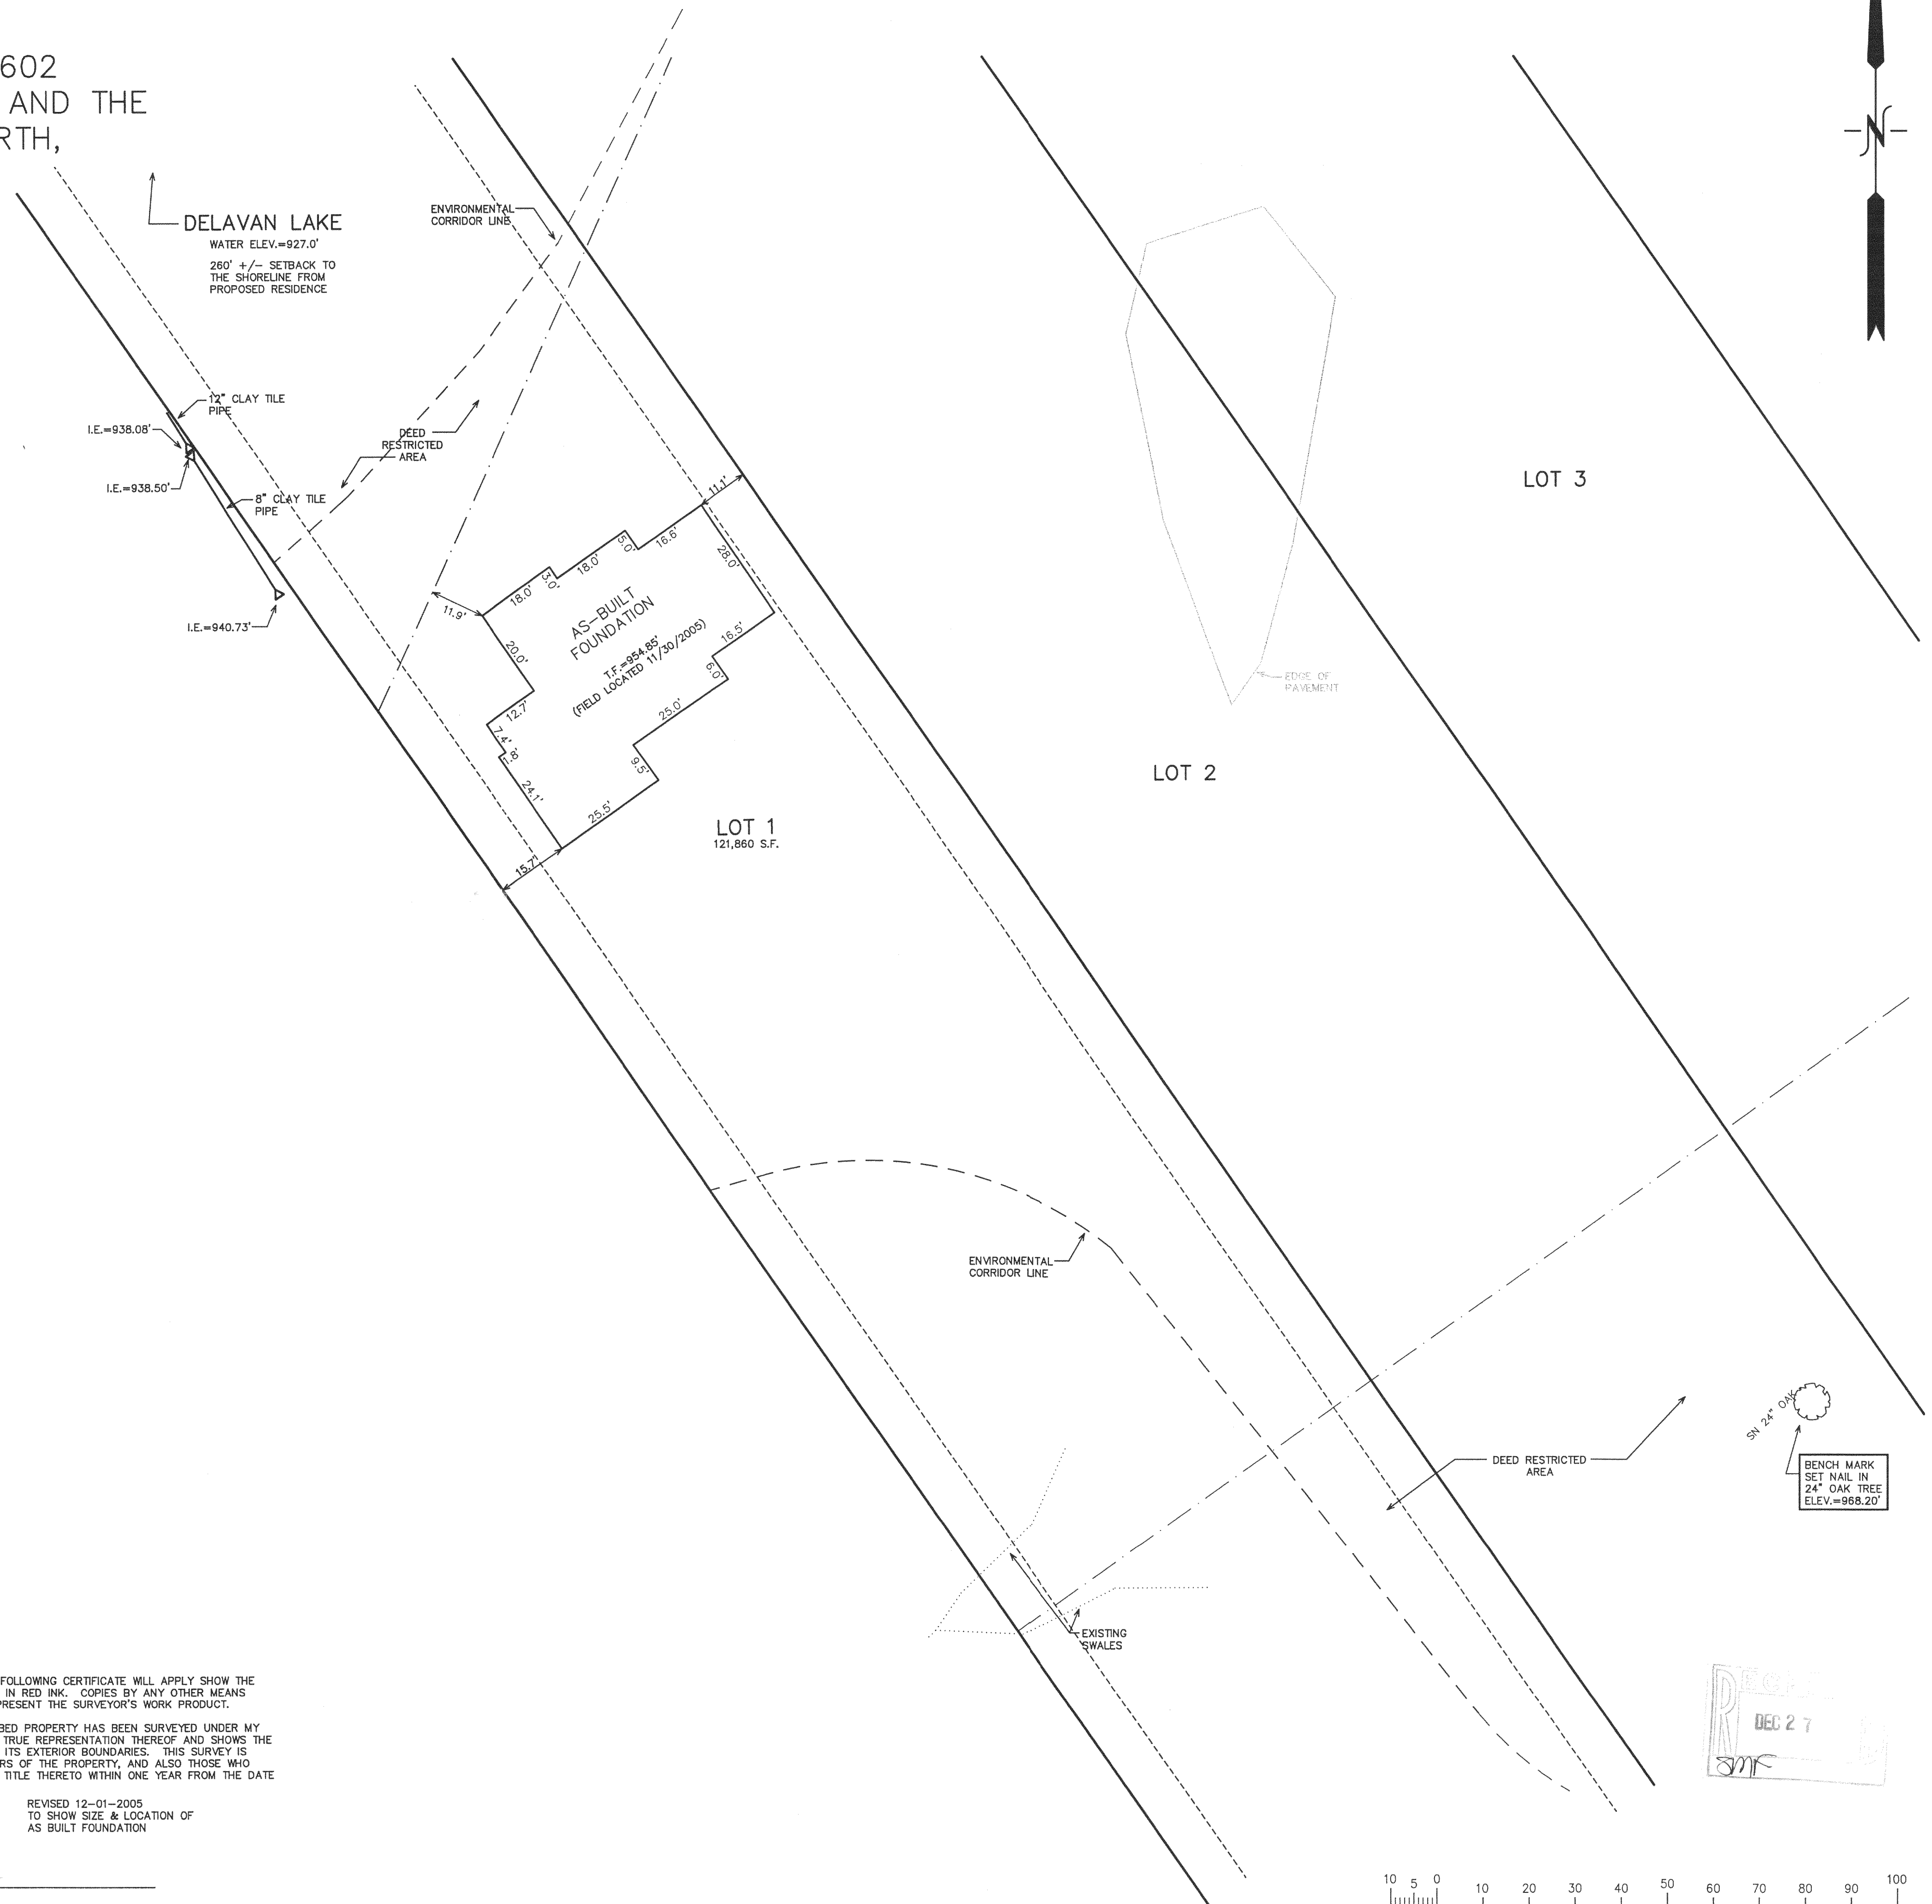


NOTE: COPIES OF THIS MAP TO WHICH THE FOLLOWING CERTIFICATE WILL APPLY SHOW THE SURVEYOR'S ORIGINAL SEAL AND SIGNATURE IN RED INK. COPIES BY ANY OTHER MEANS MAY HAVE ALTERATIONS WHICH DO NOT REPRESENT THE SURVEYOR'S WORK PRODUCT.

I HEREBY CERTIFY THAT THE ABOVE DESCRIBED PROPERTY HAS BEEN SURVEYED UNDER MY DIRECTION AND THAT THE ABOVE MAP IS A TRUE REPRESENTATION THEREOF AND SHOWS THE SIZE AND LOCATION OF THE PROPERTY AND ITS EXTERIOR BOUNDARIES. THIS SURVEY IS MADE FOR THE USE OF THE PRESENT OWNERS OF THE PROPERTY, AND ALSO THOSE WHO PURCHASE, MORTGAGE, OR GUARANTEE THE TITLE THERETO WITHIN ONE YEAR FROM THE DATE HEREOF.

REVISED 12-01-2005
TO SHOW SIZE & LOCATION OF
AS BUILT FOUNDATION

DATE: AUGUST 31, 2005

PETER S. GORDON R.L.S. 2101

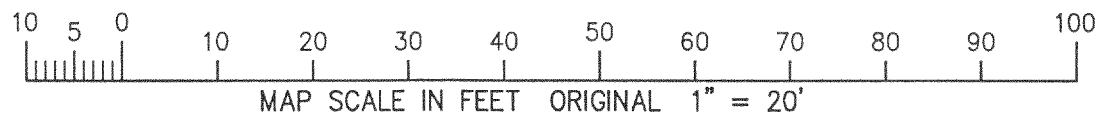

FA3678-1

216-4155