FARRIS, HANSEN & ASSOCIATES, INC.


ENGINEERING - ARCHITECTURE - SURVEYING 7 RIDGWAY COURT - P.O. BOX 437 - ELKHORN, WISCONSIN 53121 PHONE: (262) 723-2098 FAX: (262) 723-5886

- WORK ORDERED BY -JEFF CZARAPATA - CZAR CONSTRUCTION W5154 STEWART DRIVE ELKHORN, WI 53121

FEB 2 4

PLAT OF SURVEY

LOT 7 OF BLOCK 4 OF WOODLAWN BAY COMMUNITY LOCATED IN PART OF THE NW 1/4 OF THE NE 1/4 OF SECTION 28, TOWN 2 NORTH, RANGE 16 EAST, TOWN OF DELAVAN, WALWORTH COUNTY, WISCONSIN

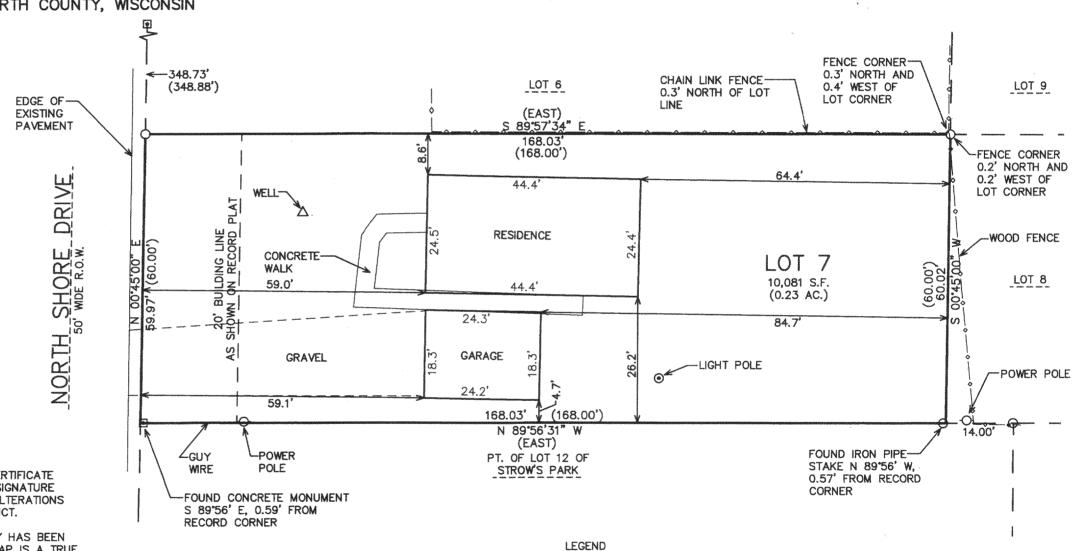

NOTE: COPIES OF THIS MAP TO WHICH THE FOLLOWING CERTIFICATE WILL APPLY SHOW THE SURVEYOR'S ORIGINAL SEAL AND SIGNATURE IN RED INK. COPIES BY ANY OTHER MEANS MAY HAVE ALTERATIONS WHICH DO NOT REPRESENT THE SURVEYOR'S WORK PRODUCT.

I HEREBY CERTIFY THAT THE ABOVE DESCRIBED PROPERTY HAS BEEN SURVEYED UNDER MY DIRECTION AND THAT THE ABOVE MAP IS A TRUE REPRESENTATION THEREOF AND SHOWS THE SIZE AND LOCATION OF THE PROPERTY AND ITS EXTERIOR BOUNDARIES. THIS SURVEY IS MADE FOR THE USE OF THE PRESENT OWNERS OF THE PROPERTY, AND ALSO THOSE WHO PURCHASE, MORTGAGE, OR GUARANTEE THE TITLE THERETO WITHIN ONE YEAR FROM THE DATE HEREOF.

DATED: JANUARY 30, 2006

PETER S. GORDON R.L.S. 2101

100 10 5 0 70 20 MAP SCALE IN FEET ORIGINAL 1" = 20'

O = FOUND IRON PIPE STAKE

(XXX) = RECORDED AS

= FOUND CONCRETE MONUMENT

PROJECT: 6972 DATE: 01/30/06 SHEET 1 OF 1

DRIVE

SHORE

NORTH

P. Ę

EAST

ASSIGNED

216-4168