
## *ABELL* SURVEYING & MAPPING



1140 SEQUOIA STREET . DELAVAN, WISCONSIN 53115 262-728-6737



NOTE: BEARINGS ARE REFERENCED TO THE RECORDED SUBDIVISION PLAT.

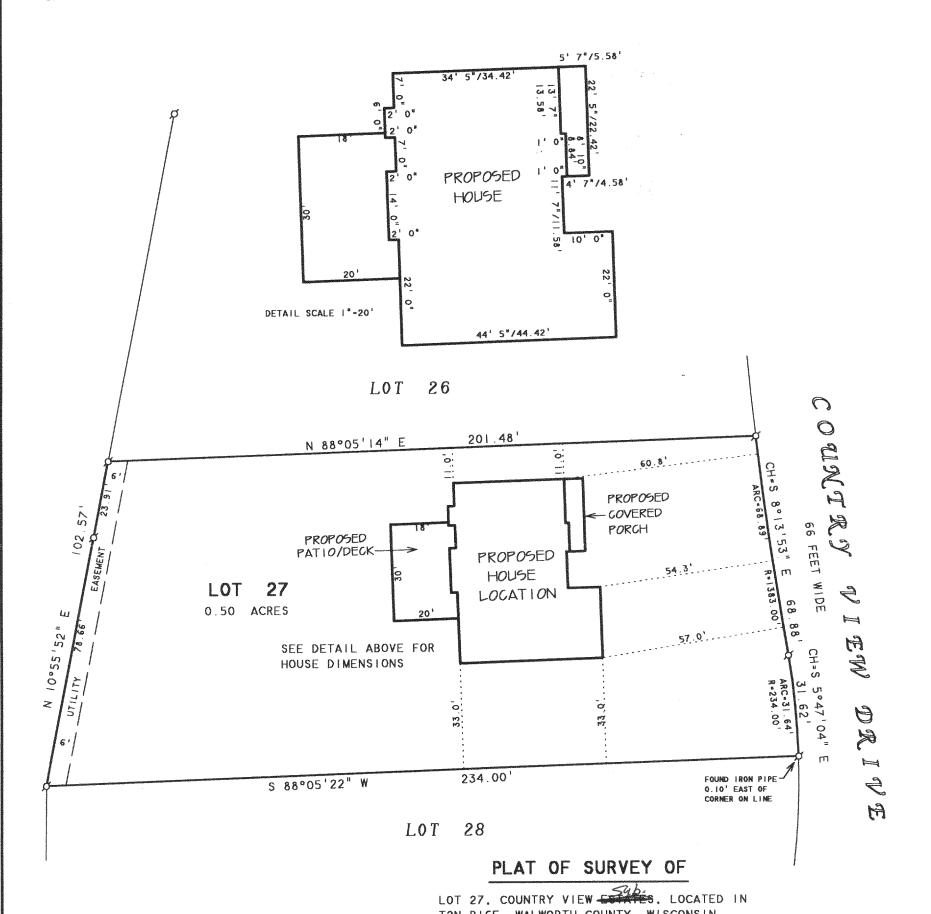



SCALE | "=30'

LEGEND

Ø - IRON PIPE FOUND

REVISED DATE: SEPTEMBER 29, 2005 REVISED TO SHOW NEW PROPOSED HOUSE LOCATION.

ORDERED BY: CURT SALLEE 233B FIFTH AVENUE WALWORTH, WI 53184 I HEREBY CERTIFY THAT I HAVE SURVEYED THE ABOVE DESCRIBED PROPERTY AND THAT THE ABOVE MAP IS A TRUE REPRESENTATION THEREOF AND SHOWS THE SIZE AND LOCATION OF THE PROPERTY, ITS EXTERIOR BOUNDARIES, THE LOCATION OF ALL VISIBLE STRUCTURES AND DIMENSIONS OF ALL PRINCIPAL BUILDINGS THEREON, BOUNDARY FENCES, APPARENT EASEMENTS, ROADWAYS AND VISIBLE ENCROACHMENTS, IF ANY, TO THE BEST OF MY KNOWLEDGE AND BELIEF

THIS SURVEY IS MADE FOR THE USE OF THE PRESENT OWNERS OF THE PROPERTY, AND ALSO THOSE WHO PURCHASE, MORTGAGE, OR GUARANTEE THE TITLE THERETO WITHIN ONE (I) YEAR FROM DATE HEREON.

DAVID F. ABELL WISCONSIN REGISTERED LAND SURVEYOR, S-1596

September 22, 2005

DATE / JOB NUMBER - 04003B NOTE: THIS IS NOT A CERTIFIED COPY UNLESS SEALED.