

— WORK ORDERED BY —  
JOHN RYAN  
ANCHORAGE OF LAKE GENEVA, LLC  
4721 RED  
LONG GROVE, IL 60047

FARRIS, HANSEN & ASSOCIATES, INC.  
ENGINEERING — ARCHITECTURE — SURVEYING  
7 RIDGWAY COURT P.O. BOX 437  
ELKHORN, WISCONSIN 53121  
OFFICE: (262) 723-2098 FAX: (262) 723-5886


REVISIONS

PROJECT NO.  
6133.02  
DATE:  
05/03/06  
SHEET NO.  
1 OF 1

# PLAT OF SURVEY

LOT 2 OF CERTIFIED SURVEY MAP NO. 3616  
REC. IN VOL. 21 ON PG. 228 AS DOC. NO. 580106

LOCATED IN PART OF THE SE 1/4 OF THE SW 1/4 OF  
SECTION 29 AND THE NE 1/4 OF THE NW 1/4 OF SECTION 32,  
TOWN 2 NORTH, RANGE 16 EAST, WALWORTH COUNTY, WISCONSIN

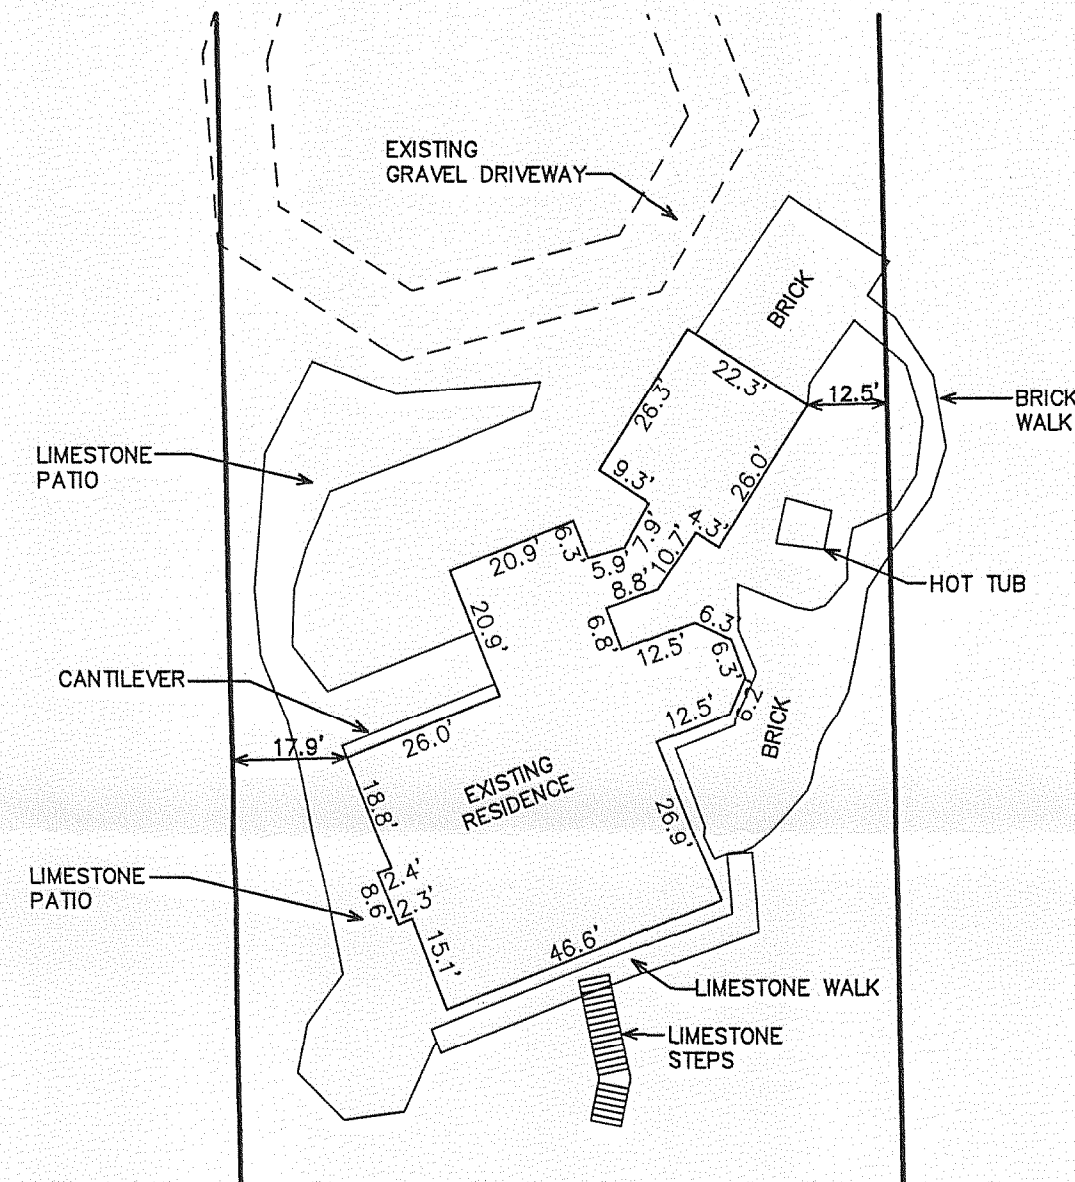

DETAIL  
SCALE: 1" = 30'

Rec'd  
MAY 17 2006  
SNC




NOTE: COPIES OF THIS MAP TO WHICH THE FOLLOWING CERTIFICATE WILL APPLY SHOW THE SURVEYOR'S ORIGINAL SEAL AND SIGNATURE IN RED INK. COPIES BY ANY OTHER MEANS MAY HAVE ALTERATIONS WHICH DO NOT REPRESENT THE SURVEYOR'S WORK PRODUCT.

I HEREBY CERTIFY THAT THE ABOVE DESCRIBED PROPERTY HAS BEEN SURVEYED UNDER MY DIRECTION AND THAT THE ABOVE MAP IS A TRUE REPRESENTATION THEREOF AND SHOWS THE SIZE AND LOCATION OF THE PROPERTY, ITS EXTERIOR BOUNDARIES, THE LOCATION OF ALL VISIBLE STRUCTURES, AND DIMENSIONS OF ALL PRINCIPLE BUILDINGS THEREON, BOUNDARY FENCES, APPARENT EASEMENTS, ROADWAYS, AND VISIBLE ENCROACHMENTS, IF ANY. THIS SURVEY IS MADE FOR THE USE OF THE PRESENT OWNERS OF THE PROPERTY, AND ALSO THOSE WHO PURCHASE, MORTGAGE, OR GUARANTEE THE TITLE THERETO WITHIN ONE YEAR FROM THE DATE HEREOF.


DATED: MAY 3, 2006

PETER S. GORDON

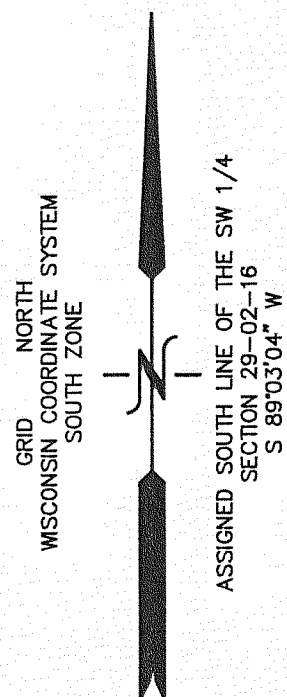

- LEGEND
- = FOUND IRON PIPE STAKE, 1 1/8" O.D.
  - = FOUND IRON REBAR STAKE, 3/4" DIA.
  - = FOUND CONCRETE COUNTY MONUMENT W/ BRASS CAP
  - = SET IRON REBAR STAKE 3/4" DIA. x 24" x 1.5 LBS./FT.
  - (XXX) = RECORDED AS

NOTE: CONSERVATION EASEMENT DESCRIBED AS DOC. NO. 596938 DOES NOT PROVIDE A SPECIFIC LOCATION (SEE DOCUMENT FOR ROUGH SKETCH). WELL EASEMENT DESCRIBED IN DOC. NO. 624836 DOES NOT PROVIDE A SPECIFIC LOCATION. APPARENT OVERHEAD UTILITIES SHOWN OF SURVEY BY ABERNATHY & ASSOCIATES DATED OCTOBER 1, 2002 DOES NOT AFFECT PROJECT PARCEL.

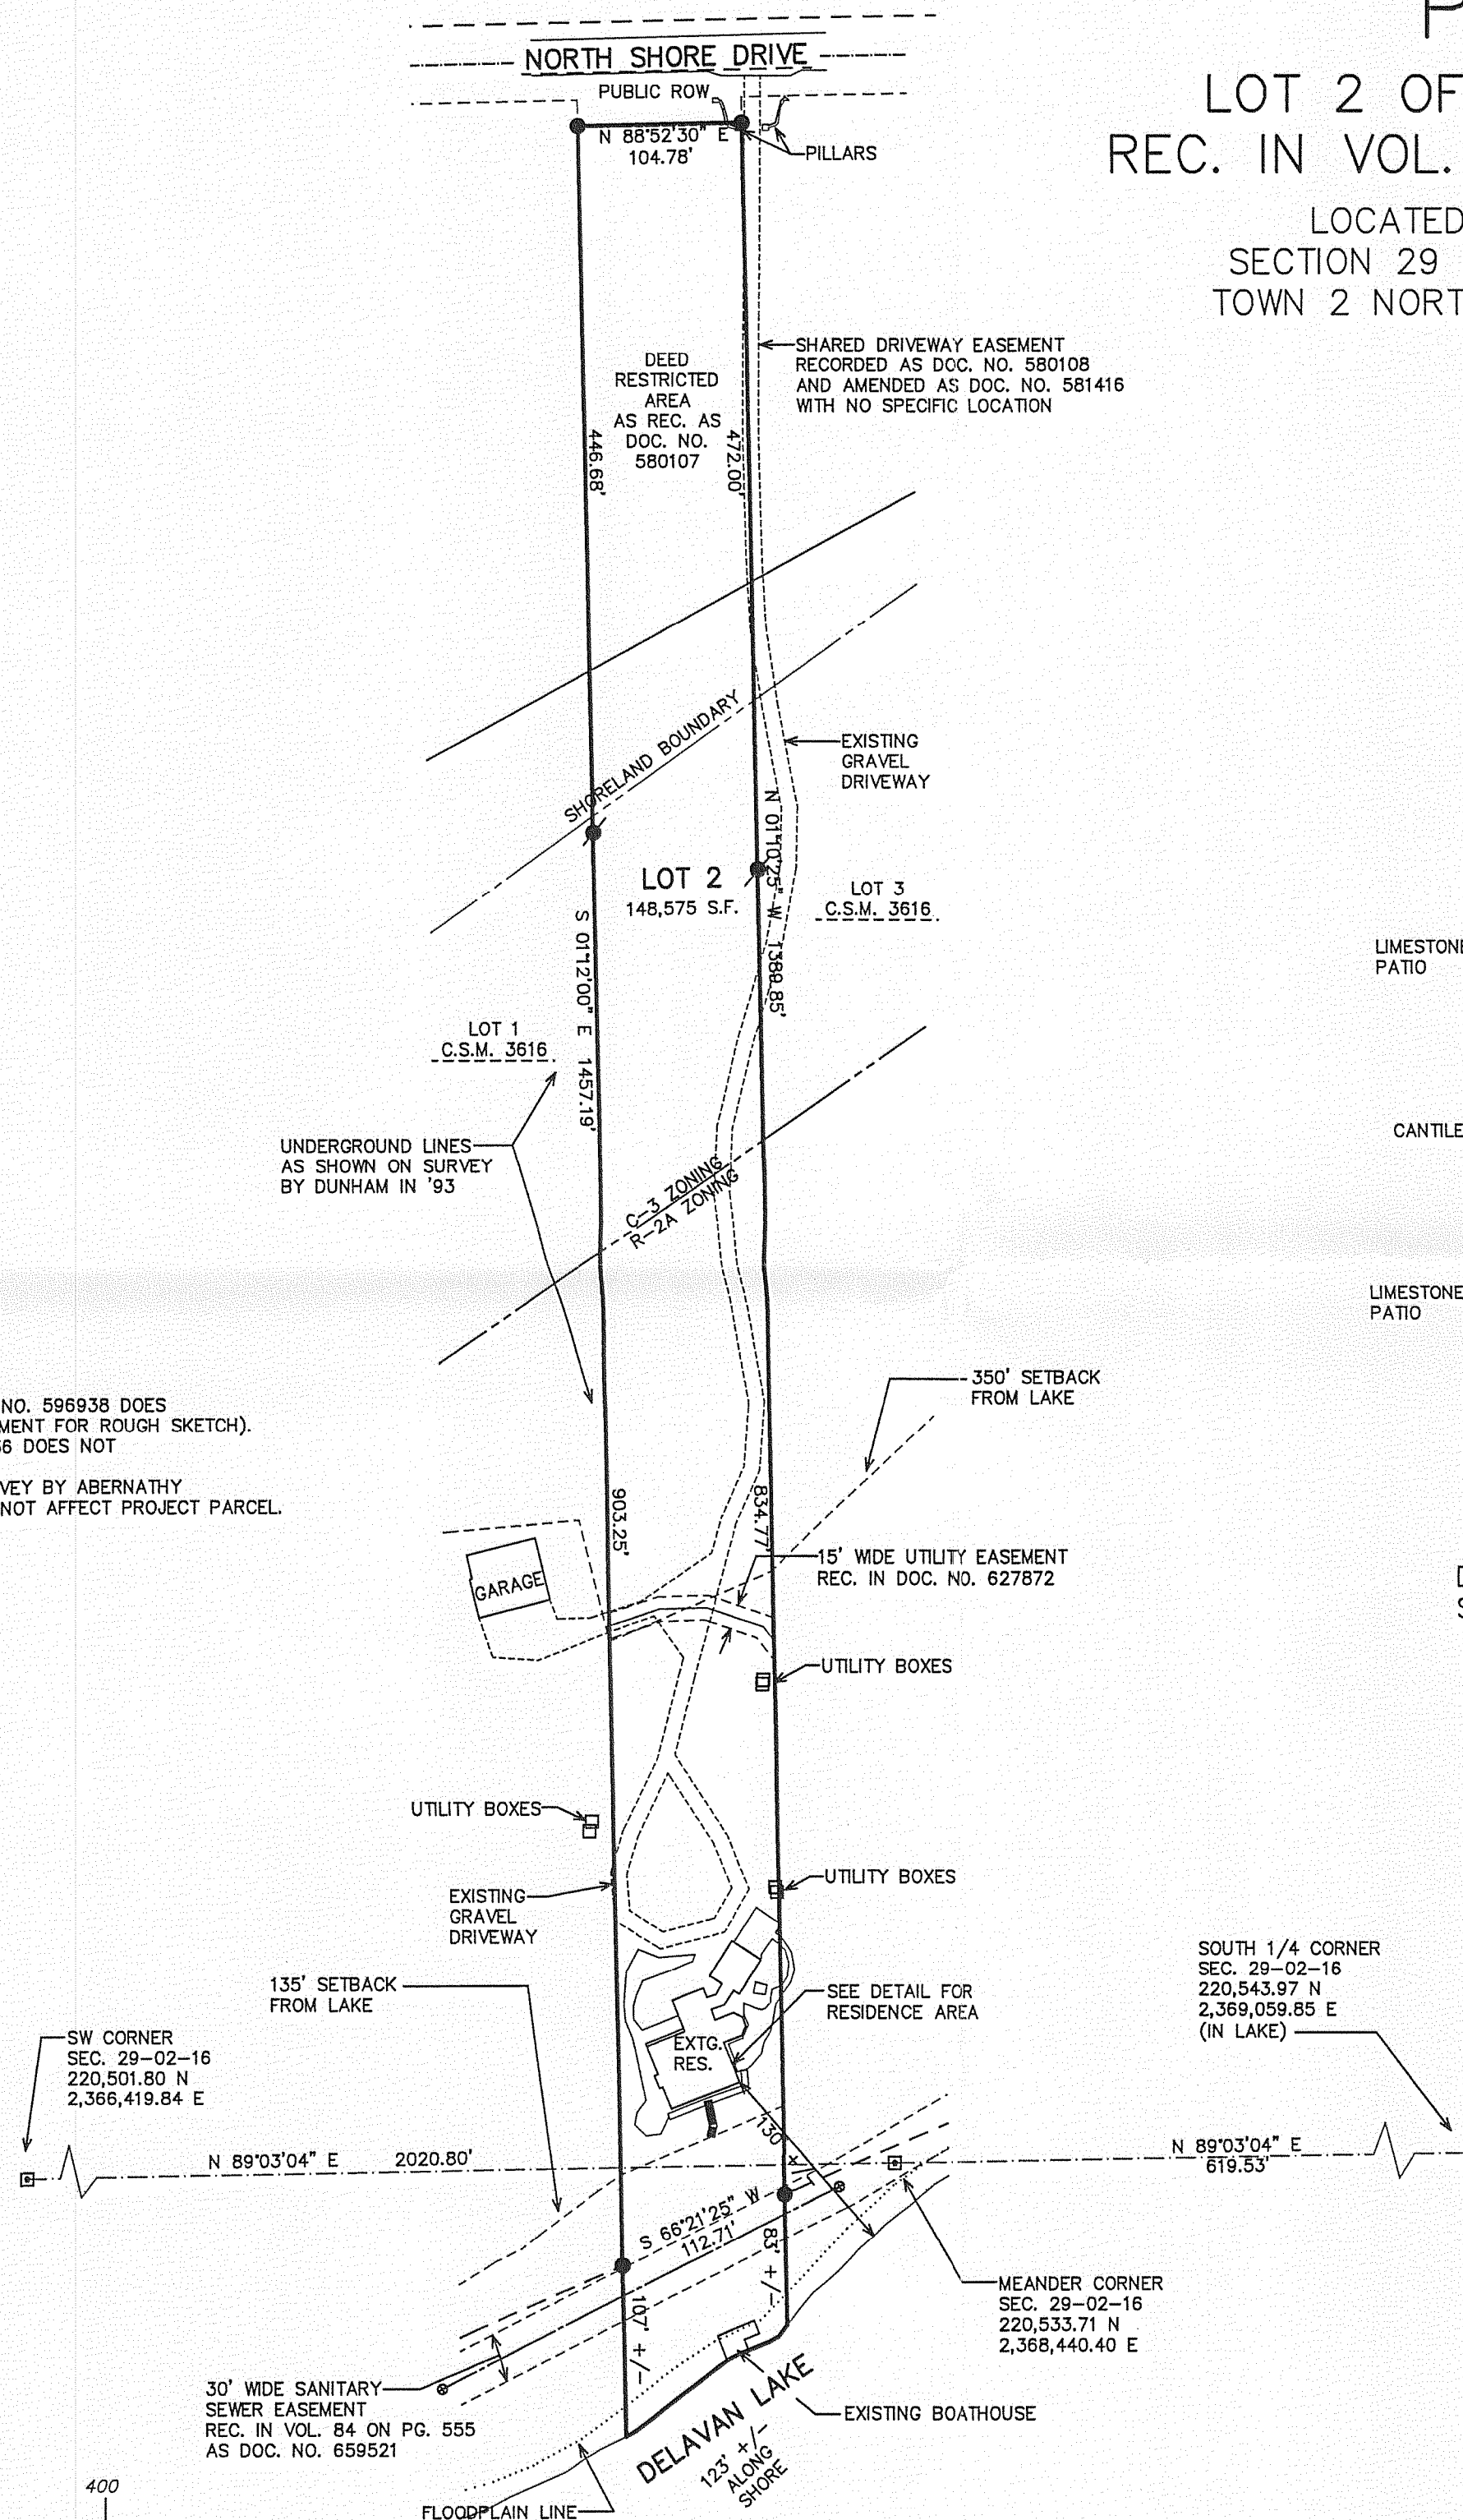

MAP SCALE IN FEET ORIGINAL 1" = 100'

FA3616-2

216-4608