
GEORGE T. DUNHAM SURVEYING & SUBDIVIDING DELAVAN, WISCONSIN

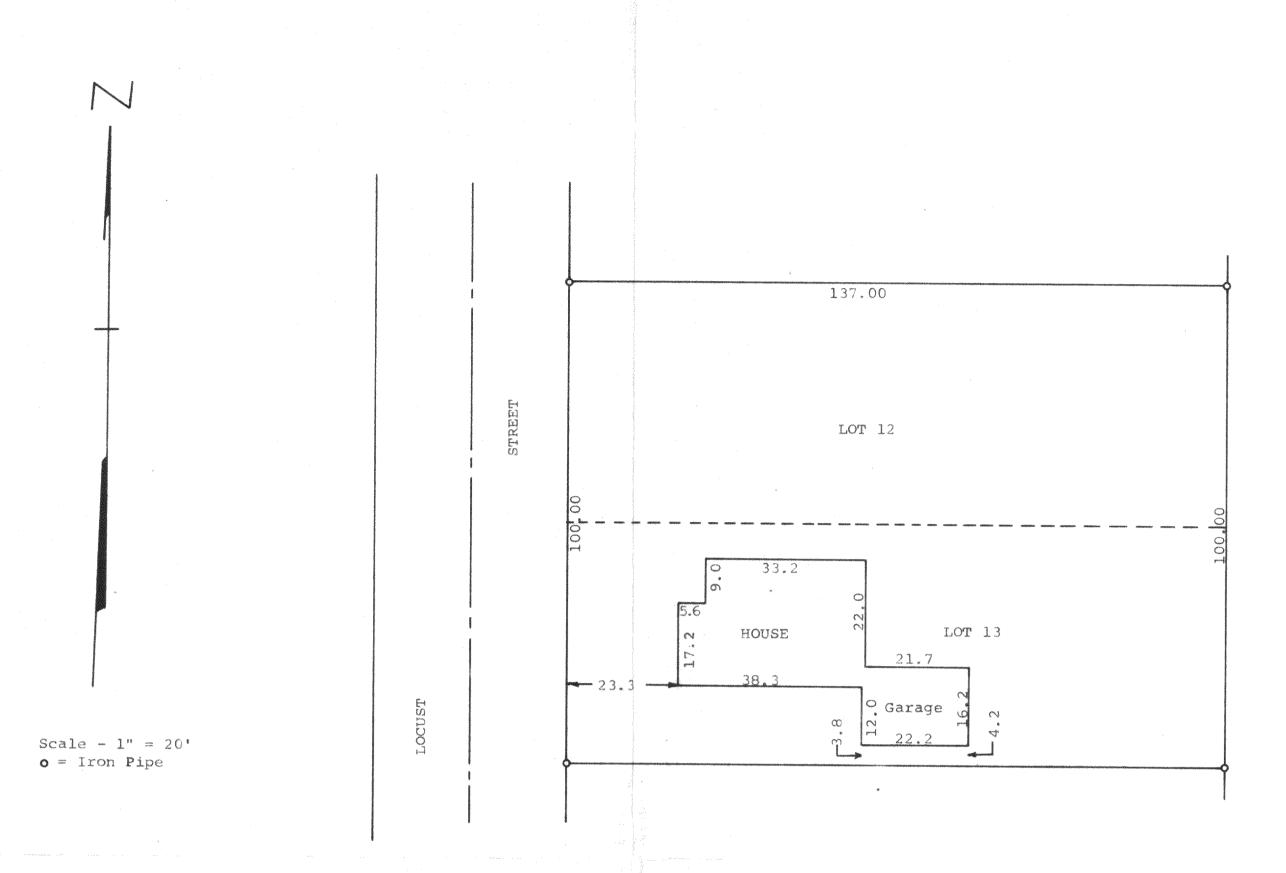

STATE OF WISCONSIN) SS COUNTY OF WALWORTH)

I, George T Dunham, Surveyor, certify that I have

surveyed the property described as follows,

Lots 12 and 13 in Lake View Subdivision located in Section 32, T 2 N, R 16 E, Walworth County, Wisconsin, and that the above plat is an accurate survey and a true representation thereof and correctly shows the exterior boundary lines and location of buildings on said property and the correct measurements thereof. January 7, 1972

George T. Dunham, Surveyor



FLA5-12

K & E 10-9155 250-10-71