


1140 SEQUOIA STREET • DELAVAN, WISCONSIN 53115
262-728-6737

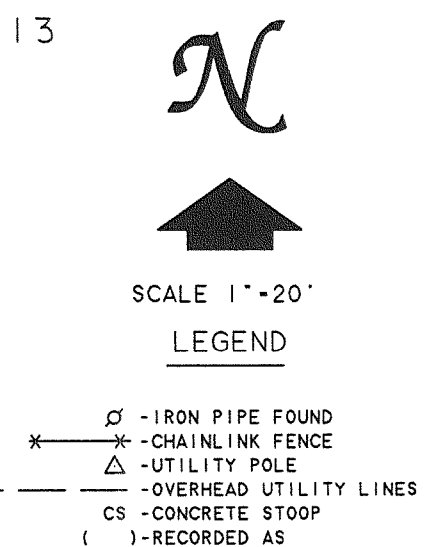

LOT 12, BLOCK 3, INLET OAKS SUBDIVISION, LOCATED
IN T2N, R16E, WALWORTH COUNTY, WISCONSIN.

THIS SURVEY IS MADE FOR THE USE OF THE PRESENT OWNERS OF THE PROPERTY, AND ALSO THOSE WHO PURCHASE, MORTGAGE, OR GUARANTEE THE TITLE THERETO WITHIN ONE (1) YEAR FROM DATE HEREON.

DAVID F. ABELL
WISCONSIN REGISTERED LAND SURVEYOR, S-1596

DATE _____ JOB NUMBER - 92012A
NOTE: THIS IS NOT A CERTIFIED COPY UNLESS SEALED.

ORDERED BY: SHOREWEST REALTORS
830 E. GENEVA STREET
DELAVER, WI 53115

FN-37

216-4231