


address: 2807 Darlington Street

Scale
1" = 30'


OWNER:

Donald James, Jr. and Jamie Neave

denotes iron
pipe found

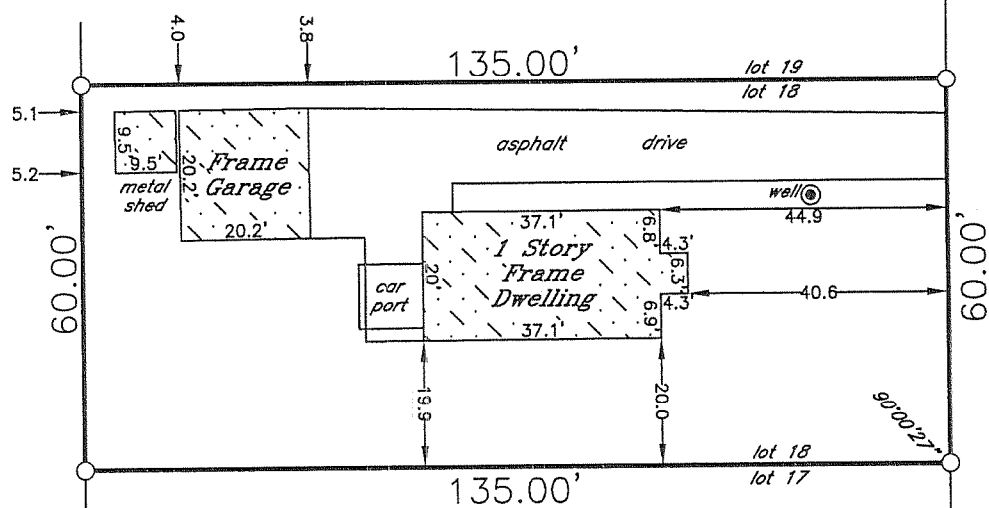

Darlington Street
(50' r/w)

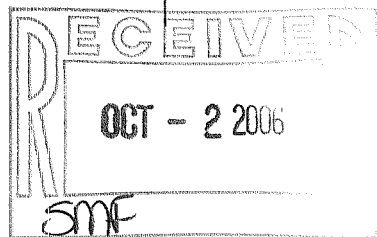


Refer to a current title report for easements or restrictions which may affect the use of this site that are not shown on the recorded subdivision plat.

J.K.R. SURVEYING, INC.
8121 22ND AVENUE, KENOSHA, WI. 53143

tax key no.: FDM00050B

I hereby certify that the above described property was surveyed under my direction and that this plat is a true representation thereof and shows the size and location of the property, its exterior boundaries, the location and dimensions of all visible structures thereon, fences, apparent easements and roadways and visible encroachments, if any.

This survey is made for the exclusive use of the present owners of the property, and those who purchase, mortgage or guarantee the title thereto, within one (1) year from the date hereof.

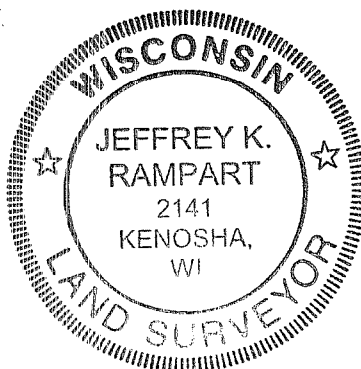

SURVEYOR
July 14, 2006

Plat of Survey of
LOT 18 BLOCK 1 IN
DELMAR SUBDIVISION
in SW1/4 Section 27-2-16
TOWN OF DELAVAN
WALWORTH COUNTY, WIS.

-for-
Jim Neave

FDM -4D

216 -4250