



1140 SEQUOIA STREET • DELAVAN, WISCONSIN 53115
262-728-6737

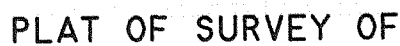

NOTE: BEARINGS ARE REFERENCED TO
EXISTING SURVEY RECORDS.

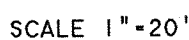

Ø - IRON PIPE FOUND
 O - IRON PIPE SET
 Δ - UTILITY POLE
 CS - CONCRETE STOOP
 WS - WOOD STOOP
 () - RECORDED AS

REVISED DATE: AUGUST 17, 2006
REVISED TO SHOW PROPOSED LOCATION
OF SHED TO BE MOVED, REMOVAL OF THE
NORTHERLY 3 FEET OF THE PLAY HOUSE
AND LOCATION OF THE EDGE OF PAVEMENT
ON CHANNEL DRIVE.

REVISED DATE: AUGUST 21, 2006
REVISED TO SHOW NEW LOCATION OF
PLAY HOUSE AND STEPS.

ORDERED BY: BILL BINGHAM
4131 SPRUCE DRIVE
DELAVER, WI 53115

I HEREBY CERTIFY THAT I HAVE SURVEYED THE ABOVE DESCRIBED PROPERTY AND THAT THE ABOVE MAP IS A TRUE REPRESENTATION THEREOF AND SHOWS THE SIZE AND LOCATION OF THE PROPERTY, ITS EXTERIOR BOUNDARIES, THE LOCATION OF ALL VISIBLE STRUCTURES AND DIMENSIONS OF ALL PRINCIPAL BUILDINGS THEREON, BOUNDARY FENCES, APPARENT EASEMENTS, ROADWAYS AND VISIBLE ENCROACHMENTS, IF ANY, TO THE BEST OF MY KNOWLEDGE AND BELIEF.

THIS SURVEY IS MADE FOR THE USE OF THE PRESENT OWNERS OF THE PROPERTY, AND ALSO THOSE WHO PURCHASE, MORTGAGE, OR GUARANTEE THE TITLE THERETO WITHIN ONE (1) YEAR FROM DATE HEREON.

FROM DATE HEREON.

Daniel F. Hall

DAVID F. ABELL
WISCONSIN REGISTERED LAND SURVEYOR, S-1596

June 21, 2006

DATE _____ JOB NUMBER - 99047E
NOTE: THIS IS NOT A CERTIFIED COPY UNLESS SEALED.

FLAD-143

216 - 4267