

SUTTER

AVENUE

ABELL
SURVEYING & MAPPING1140 SEQUOIA STREET • DELAVAN, WISCONSIN 53115
262-728-6737BEARINGS ARE REFERENCED TO THE
RECORDED SUBDIVISION PLAT.


N



SCALE 1"=20'

LEGEND

- ⊗ - IRON PIPE FOUND
- ✕ - CHAINLINK FENCE
- △ - UTILITY POLE
- () - RECORDED AS

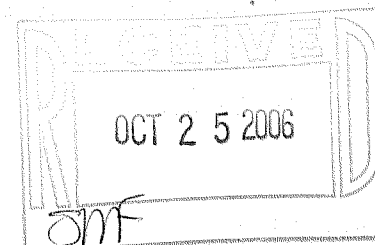

PLAT OF SURVEY OF


LOTS 8 AND 9, BLOCK 16, DELMAR SUBDIVISION,
LOCATED IN T2N, R16E, WALWORTH COUNTY,
WISCONSIN.

I HEREBY CERTIFY THAT I HAVE SURVEYED THE ABOVE DESCRIBED PROPERTY AND THAT THE ABOVE MAP IS A TRUE REPRESENTATION THEREOF AND SHOWS THE SIZE AND LOCATION OF THE PROPERTY, ITS EXTERIOR BOUNDARIES, THE LOCATION OF ALL VISIBLE STRUCTURES AND DIMENSIONS OF ALL PRINCIPAL BUILDINGS THEREON, BOUNDARY FENCES, APPARENT EASEMENTS, ROADWAYS AND VISIBLE ENCROACHMENTS, IF ANY, TO THE BEST OF MY KNOWLEDGE AND BELIEF.

THIS SURVEY IS MADE FOR THE USE OF THE PRESENT OWNERS OF THE PROPERTY, AND ALSO THOSE WHO PURCHASE, MORTGAGE, OR GUARANTEE THE TITLE THERETO WITHIN ONE (1) YEAR FROM DATE HEREON.

DAVID F. ABELL
WISCONSIN REGISTERED LAND SURVEYOR, S-1596

August 10, 2006

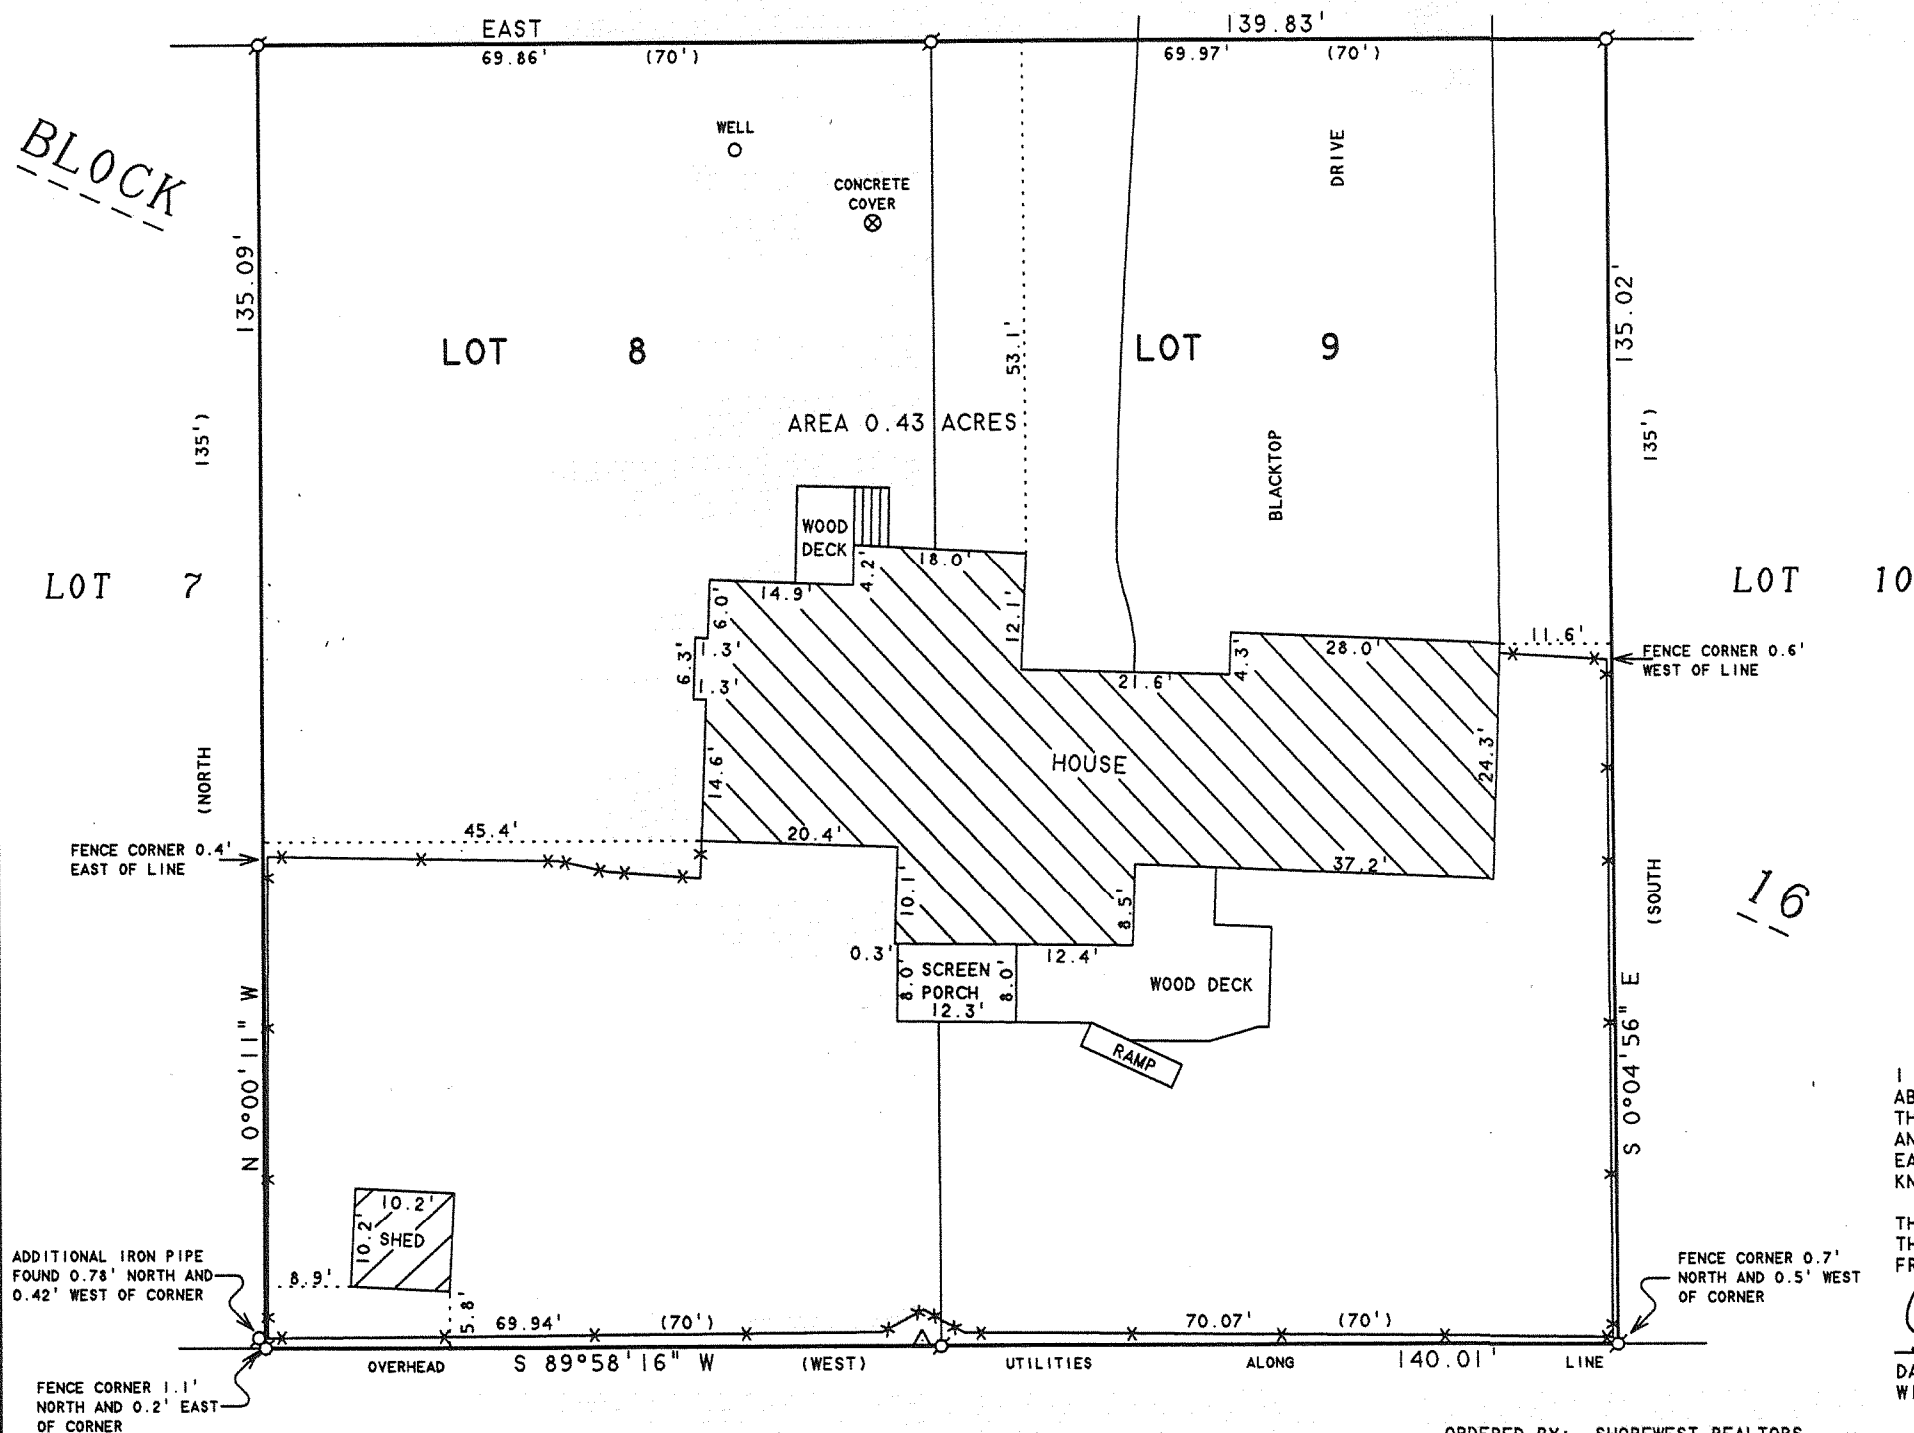DATE: August 10, 2006 JOB NUMBER - 06074
NOTE: THIS IS NOT A CERTIFIED COPY UNLESS SEALED.ORDERED BY: SHOREWEST REALTORS
830 E. GENEVA STREET
DELAVAN, WI 53115

FDM-71D

216-4271