
PREPARED FOR: ONEIDA WHEELER SHOREWEST REALTORS 830 EAST GENEVA, ST. DELAVAN, WI 53115

PLAT OF SURVEY

- OF -

J.K. SURVEYING INC. N3705 WILLOWBEND LANE LAKE GENEVA, WI 53147 (262) 248-3697

LOTS 6 - 7, BLOCK 13 DELAVAN LAKE VIEW CREST SUBDIVISION, A SUBDIVISION LOCATED IN SECTION 31 TOWN 2 NORTH, RANGE 16 EAST OF THE FOUTH PRINCIPLE MERIDIAN, TOWN OF DELAVAN, WALWORTH COUNTY, WISCONSIN

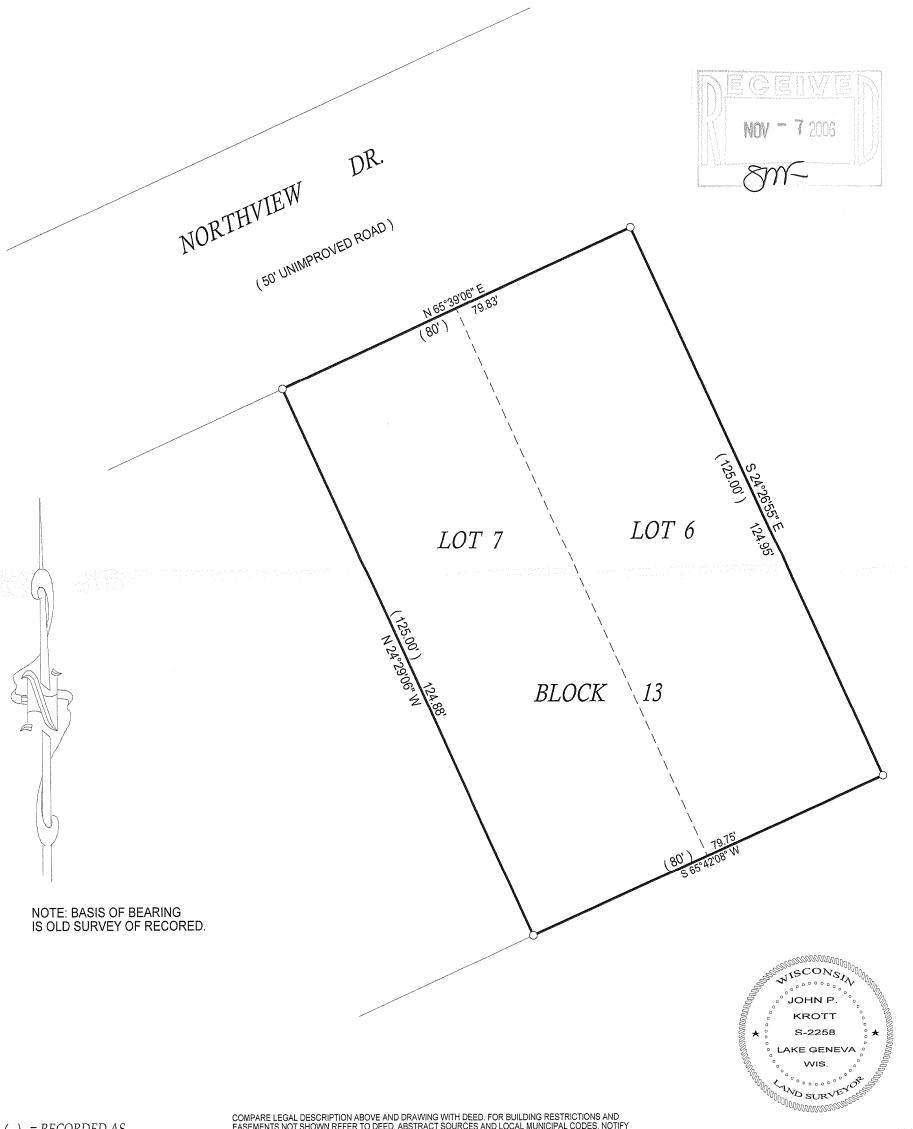

() = RECORDED AS

□ = FOUND IRON BAR

○ = FOUND IRON PIPE

= SET IRON BAR

= SET IRON PIPE

SCALE: 1" = 20'

JOB # 04-639 TAX ID # FDLV 00051A COMPARE LEGAL DESCRIPTION ABOVE AND DRAWING WITH DEED. FOR BUILDING RESTRICTIONS AND EASEMENTS NOT SHOWN, REFER TO DEED, ABSTRACT SOURCES AND LOCAL MUNICIPAL CODES. NOTIFY THE SURVEYOR IMMEDIATELY OF ANY DISCREPANCY.

"I hereby certify that I have surveyed the above described property and that the above map, to the best of my knowledge and belief, is a true representation thereof and shows the size and location of all visible structures, apparent easements and encroachments if any."

This survey is made for the present owners of the property, and those who purchase, mortgage, or guarantee the title thereto, within one year from the date hereof.

DATED THIS __14__TH, DAY OF DECEMBER_ 2004.

DATE OF LAST REVISION: 10/16/2006

JOHN KROTT S - 2258 Wisconsin Registered Land Surveyor (original if signed in red)

216-4289