


LOCATED IN PART OF SECTION 28, TOWN 2 NORTH, RANGE 16 EAST,
TOWN OF DELAVAN, WALWORTH COUNTY, WISCONSIN

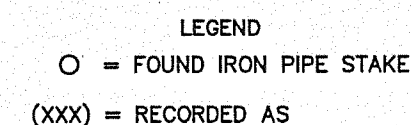


NOTE: COPIES OF THIS MAP TO WHICH THE FOLLOWING CERTIFICATE
WILL APPLY SHOW THE SURVEYOR'S ORIGINAL SEAL AND SIGNATURE
IN RED INK. COPIES BY ANY OTHER MEANS MAY HAVE ALTERATIONS
WHICH DO NOT REPRESENT THE SURVEYOR'S WORK PRODUCT.

I HEREBY CERTIFY THAT THE ABOVE DESCRIBED PROPERTY HAS BEEN SURVEYED UNDER MY DIRECTION AND THAT THE ABOVE MAP IS A TRUE REPRESENTATION THEREOF AND SHOWS THE SIZE AND LOCATION OF THE PROPERTY AND ITS EXTERIOR BOUNDARIES. THIS SURVEY IS MADE FOR THE USE OF THE PRESENT OWNERS OF THE PROPERTY, AND ALSO THOSE WHO PURCHASE, MORTGAGE, OR GUARANTEE THE TITLE THERETO WITHIN ONE YEAR FROM THE DATE HEREOF.

DATED: NOVEMBER 29, 2005

REVISED 11-03-2006
TO SHOW SIZE & LOCATION OF
AS BUILT GARAGE & RESIDENCE

PETER S. GORDON R.L.S. 2101

BERMAN
RESIDENCE

— WORK ORDERED BY —
SHANNON LASSITER
ORREN PICKELL DESIGNERS & BUILDERS
200 TRI-STATE INTERNATIONAL, SUITE 200
LINCOLNSHIRE, IL 60069

FARRIS, HANSEN & ASSOCIATES, INC.
ENGINEERING - ARCHITECTURE - SURVEYING
7 RIDGWAY COURT P.O. BOX 437
ELKHORN, WISCONSIN 53121
OFFICE: (262) 723-2098 FAX: (262) 723-5886

REVISIONS

06/15/2006
SITE, GRADING,
DRAINAGE, &
EROSION
CONTROL PLAN

07/14/2006

MISC. REVISIONS

08/07/06

MISC. REVISIONS
 10/17/200008/17/2006
REVISED PRO.

REVISED PRO.
DRIVEWAY

LOCATION

1. *Chlorophyll a* and *Chlorophyll b* were determined by the method of Arar and Collins (1971) using a Shimadzu 1010 spectrophotometer.

1. **Introduction**

PROJECT NO.

6932

DATE: _____

DATE:
11/29/05

SHEET NO.

SHEET NO.
1 OF 1

Page 10

216 - 4292

FS-7