
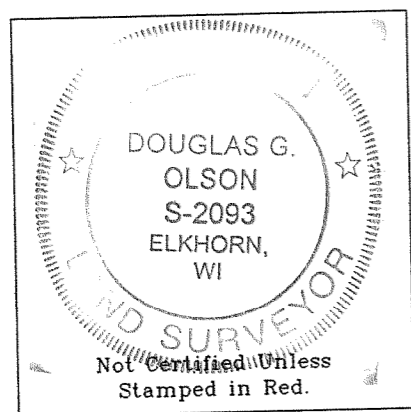


# Plat of Survey


of

Lot 36 of the First Addition to Lakewood Estates,  
a subdivision located in the Southwest 1/4 of Section 21, Town 2  
North, Range 16 East, Town of Delavan, Walworth County, Wisconsin.

Surveyed for: **John Mendygral**  
1819 Lake Trail Drive  
Delavan, Wisconsin. 53115

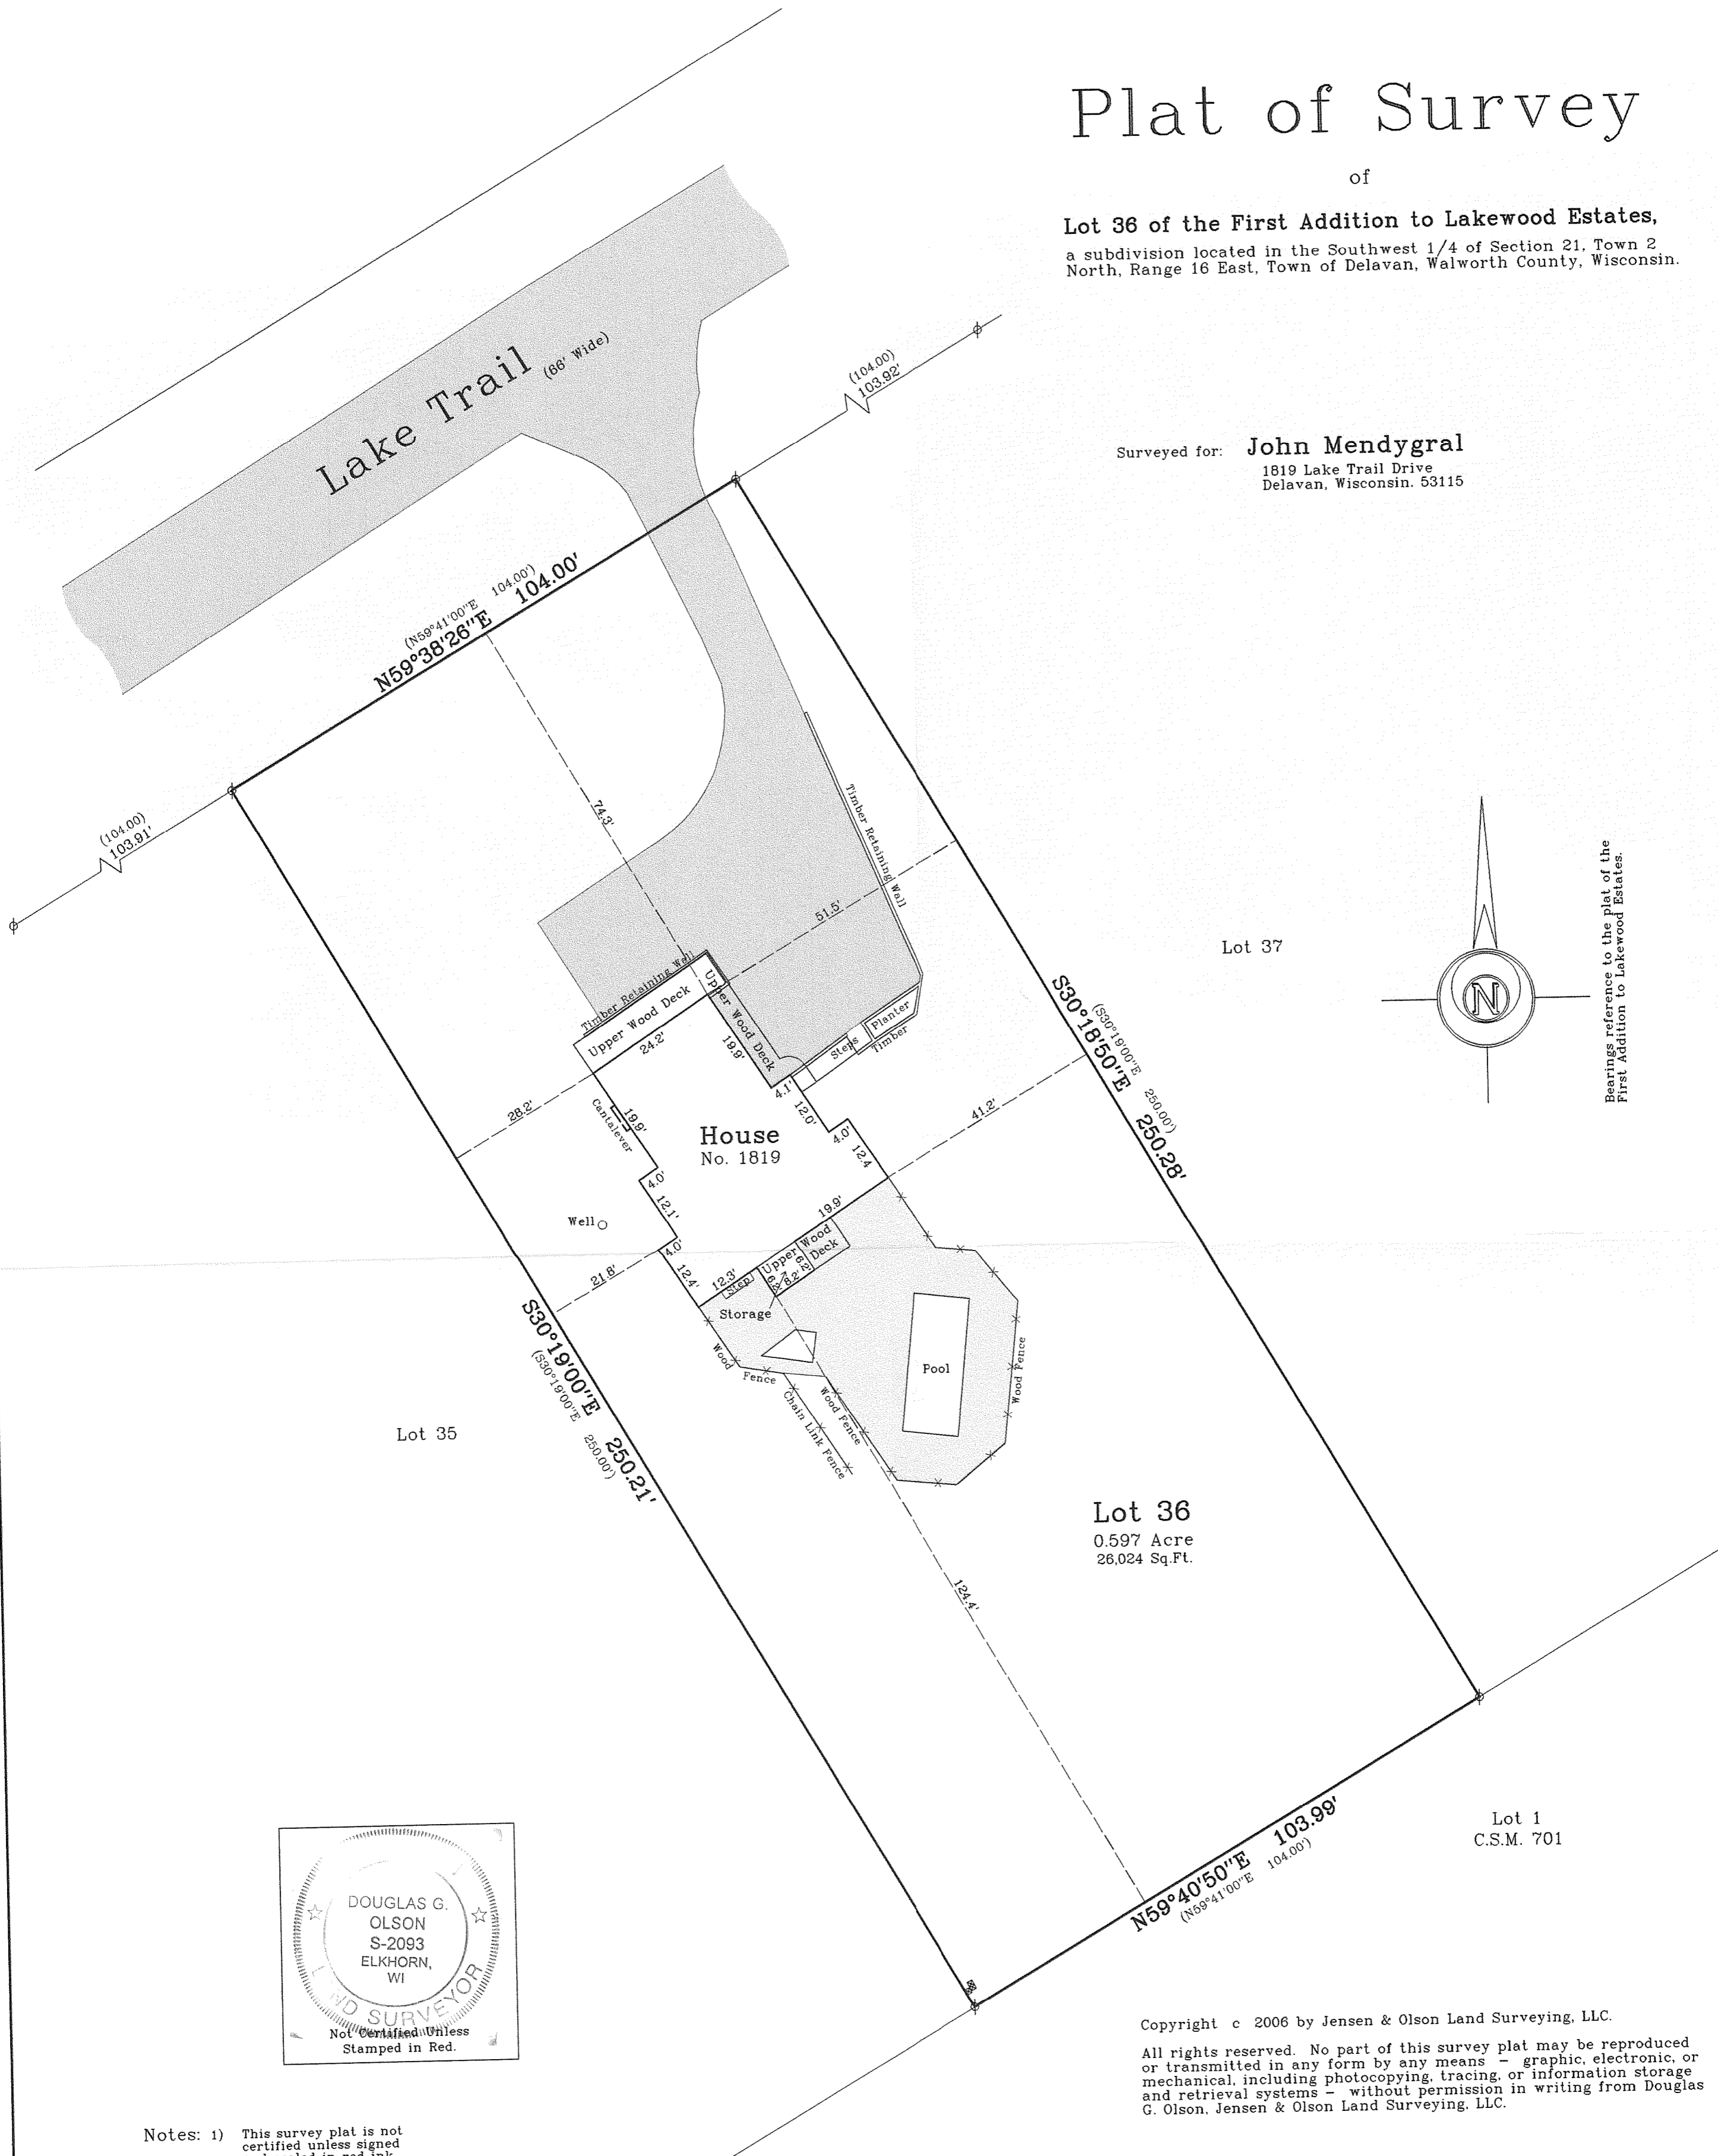

- Notes: 1) This survey plat is not certified unless signed and sealed in red ink.
- 2) This survey is subject to Wisconsin lien laws. This Plat of Survey is the notice of intent to file lien. Lien waiver required.

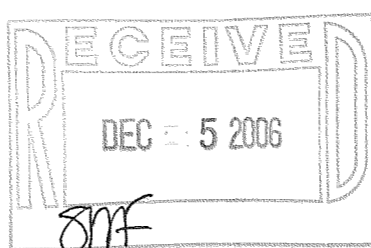

Copyright © 2006 by Jensen & Olson Land Surveying, LLC.

All rights reserved. No part of this survey plat may be reproduced or transmitted in any form by any means - graphic, electronic, or mechanical, including photocopying, tracing, or information storage and retrieval systems - without permission in writing from Douglas G. Olson, Jensen & Olson Land Surveying, LLC.

I hereby certify that I have surveyed the above described property and the map hereon is correct to the best of my professional knowledge and belief and shows the size and location of the property, its exterior boundaries, the location and dimensions of all visible structures thereon, boundary fences, apparent easements and roadways and visible encroachments, if any.

This survey is made for the exclusive use of the present owners of property, and also those who purchase, mortgage or guarantee title thereto, within one year from the date hereof.

Douglas G. Olson  
Wisconsin Registered Land Surveyor - 2093

2006.124  
Sheet 1 of 1 Sheets  
Job Reference Number  
**2006.124**

**Legend**


- φ Found Iron Pipe
- ( ) Recorded Information
- Pedestal
- ▨ Asphalt Surface
- ▩ Concrete Surface



**Jensen & Olson Land Surveying, LLC**

45 South Wisconsin Street P.O. Box 322  
Elkhorn, Wisconsin. 53121  
Telephone (262) 723-3434  
Facsimile (262) 723-8044

Scale in Feet  
1" = 20'

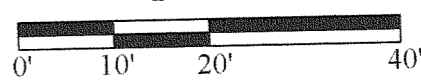

Survey Date: October 27, 2006.  
Revisions:

FLEA-16

216-4298