
ABELL SURVEYING & MAPPING

1140 SEQUOIA STREET • DELAVAN. WISCONSIN 53115 262-728-6737





NOTE: BEARINGS ARE REFERENCED TO EXISTING SURVEY RECORDS.

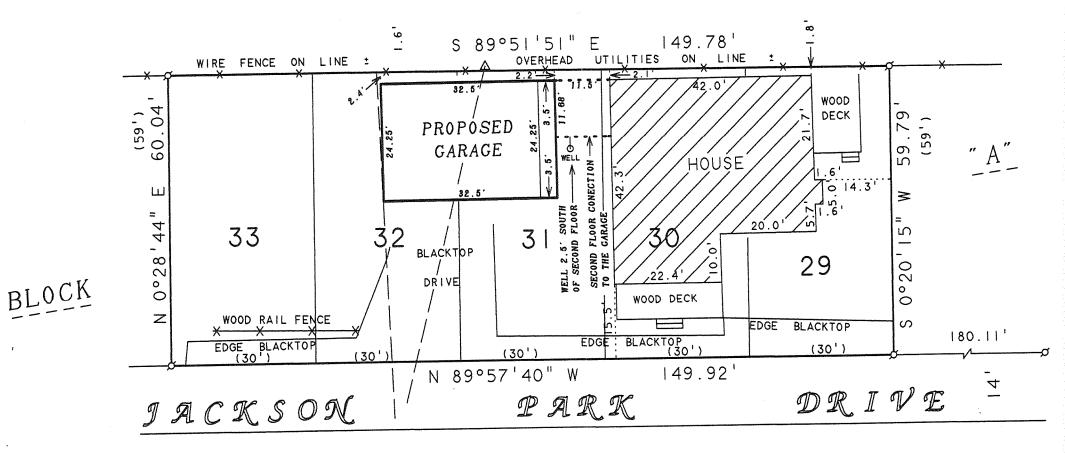



SCALE | " = 20'

LEGEND

Q - IRON PIPE FOUND

□ - UTILITY POLE

- - OVERHEAD UTILITY LINES

-X - WIRE FENCE
 () - RECORDED AS

PLAT OF SURVEY OF

LOTS 29-33, BLOCK A, JACKSON SUBDIVISION, T2N, RIGE, WALWORTH COUNTY, WISCONSIN.

ORDERED BY: RE/MAX-LAKES AREA REALTORS 1815 N. SHORE DRIVE DELAVAN. WI. 53115

REVISED: MAY 5, 2006 TO SHOW THE PROPOSED GARAGE AND SECOND FLOOR CONNECTION, THE OLD GARAGE WAS GONE.
ORDERED BY: RICHARD SORENSEN
DESIGN DEVELOPMENT
1175 LAKE GENEVA BLVD.
LAKE GENEVA, WI 53147

I HEREBY CERTIFY THAT I HAVE SURVEYED THE ABOVE DESCRIBED PROPERTY AND THAT THE ABOVE MAP IS A TRUE REPRESENTATION THEREOF AND SHOWS THE SIZE AND LOCATION OF THE PROPERTY, ITS EXTERIOR BOUNDARIES, THE LOCATION OF ALL VISIBLE STRUCTURES AND DIMENSIONS OF ALL PRINCIPAL BUILDINGS THEREON, BOUNDARY FENCES, APPARENT EASEMENTS, ROADWAYS AND VISIBLE ENCROACHMENTS, IF ANY, TO THE BEST OF MY KNOWLEDGE AND BELIEF.

THIS SURVEY IS MADE FOR THE USE OF THE PRESENT OWNERS OF THE PROPERTY, AND ALSO THOSE WHO PURCHASE, MORTGAGE, OR GUARANTEE THE TITLE THERETO WITHIN ONE (1) YEAR FROM DATE HEREON.

DAVID F. ABELL WISCONSIN REGISTERED LAND SURVEYOR, S-1596

April 11. Zooc

JOB NUMBER - 00043A

NOTE: THIS IS NOT A CERTIFIED COPY UNLESS SEALED.

- / /

216-4312