

ABELL
SURVEYING & MAPPING

1140 SEQUOIA STREET • DELAVAN, WISCONSIN 53115
262-728-6737

N



SCALE 1"=10'

LEGEND

- - IRON ROD FOUND
- + - CUTCROSS IN CONCRETE SPILLWAY SET
- ⊗ - 60d SPIKE SET, UNABLE TO SET IRON PIPE AT THIS LOCATION

LOT 11

HOUSE

CONCRETE SPILLWAY

WELL

LOT 10
0.06 ACRES

FIELD

PLACE

HOUSE FOUNDATION
LOCATED 3/6/07

CUTCROSS IN CONCRETE
WALL FOUND

89°59'22"

14.8'

CONCRETE CURB
30.00'

CONCRETE CURBING 0.3'
WEST OF LINE

CONCRETE SIDEWALK

OLD WELL PUMP

EDGE OF RAIN GUTTER ON
HOUSE TO SOUTH EXTENDS
0.07' NORTH OF LINE

LOT 9

I HEREBY CERTIFY THAT I HAVE SURVEYED THE ABOVE DESCRIBED PROPERTY AND THAT THE ABOVE MAP IS A TRUE REPRESENTATION THEREOF AND SHOWS THE SIZE AND LOCATION OF THE PROPERTY, ITS EXTERIOR BOUNDARIES, THE LOCATION OF ALL VISIBLE STRUCTURES AND DIMENSIONS OF ALL PRINCIPAL BUILDINGS THEREON, BOUNDARY FENCES, APPARENT EASEMENTS, ROADWAYS AND VISIBLE ENCROACHMENTS, IF ANY, TO THE BEST OF MY KNOWLEDGE AND BELIEF.

THIS SURVEY IS MADE FOR THE USE OF THE PRESENT OWNERS OF THE PROPERTY, AND ALSO THOSE WHO PURCHASE, MORTGAGE, OR GUARANTEE THE TITLE THERETO WITHIN ONE (1) YEAR FROM DATE HEREON.

David F. Abell

DAVID F. ABELL
WISCONSIN REGISTERED LAND SURVEYOR, S-1596

January 16, 2006

DATE
NOTE: THIS IS NOT A CERTIFIED COPY UNLESS SEALED. JOB NUMBER - 06002C

PLAT OF SURVEY OF

LOT 10, BLOCK G, DELAVAN LAKE ASSEMBLY
GROUNDS, T2N,R16E, WALWORTH COUNTY,
WISCONSIN.


ORDERED BY: JIM DUIGNAN
3542 W. 115th STREET
CHICAGO, IL 60655

REVISED DATE: AUGUST 17, 2006
REVISED TO SHOW PROPOSED HOUSE,
COVERED PORCH AND STEPS LOCATION.

REVISED DATE: AUGUST 21, 2006
REVISED TO SHOW NEW PROPOSED HOUSE
DIMENSIONS AND SHED TO BE REMOVED.

REVISED DATE: MARCH 6, 2007 TO SHOW
NEW HOUSE FOUNDATION.

ORDERED BY: ZELL'S WOODWORKING INC.
1299 CENTER STREET
DELAVAN, WI 53115

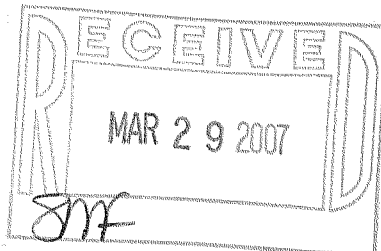

FDLA-85

216-4314