


# ABELL SURVEYING & MAPPING

1140 SEQUOIA STREET • DELAVAN, WISCONSIN 53115  
262-728-6737

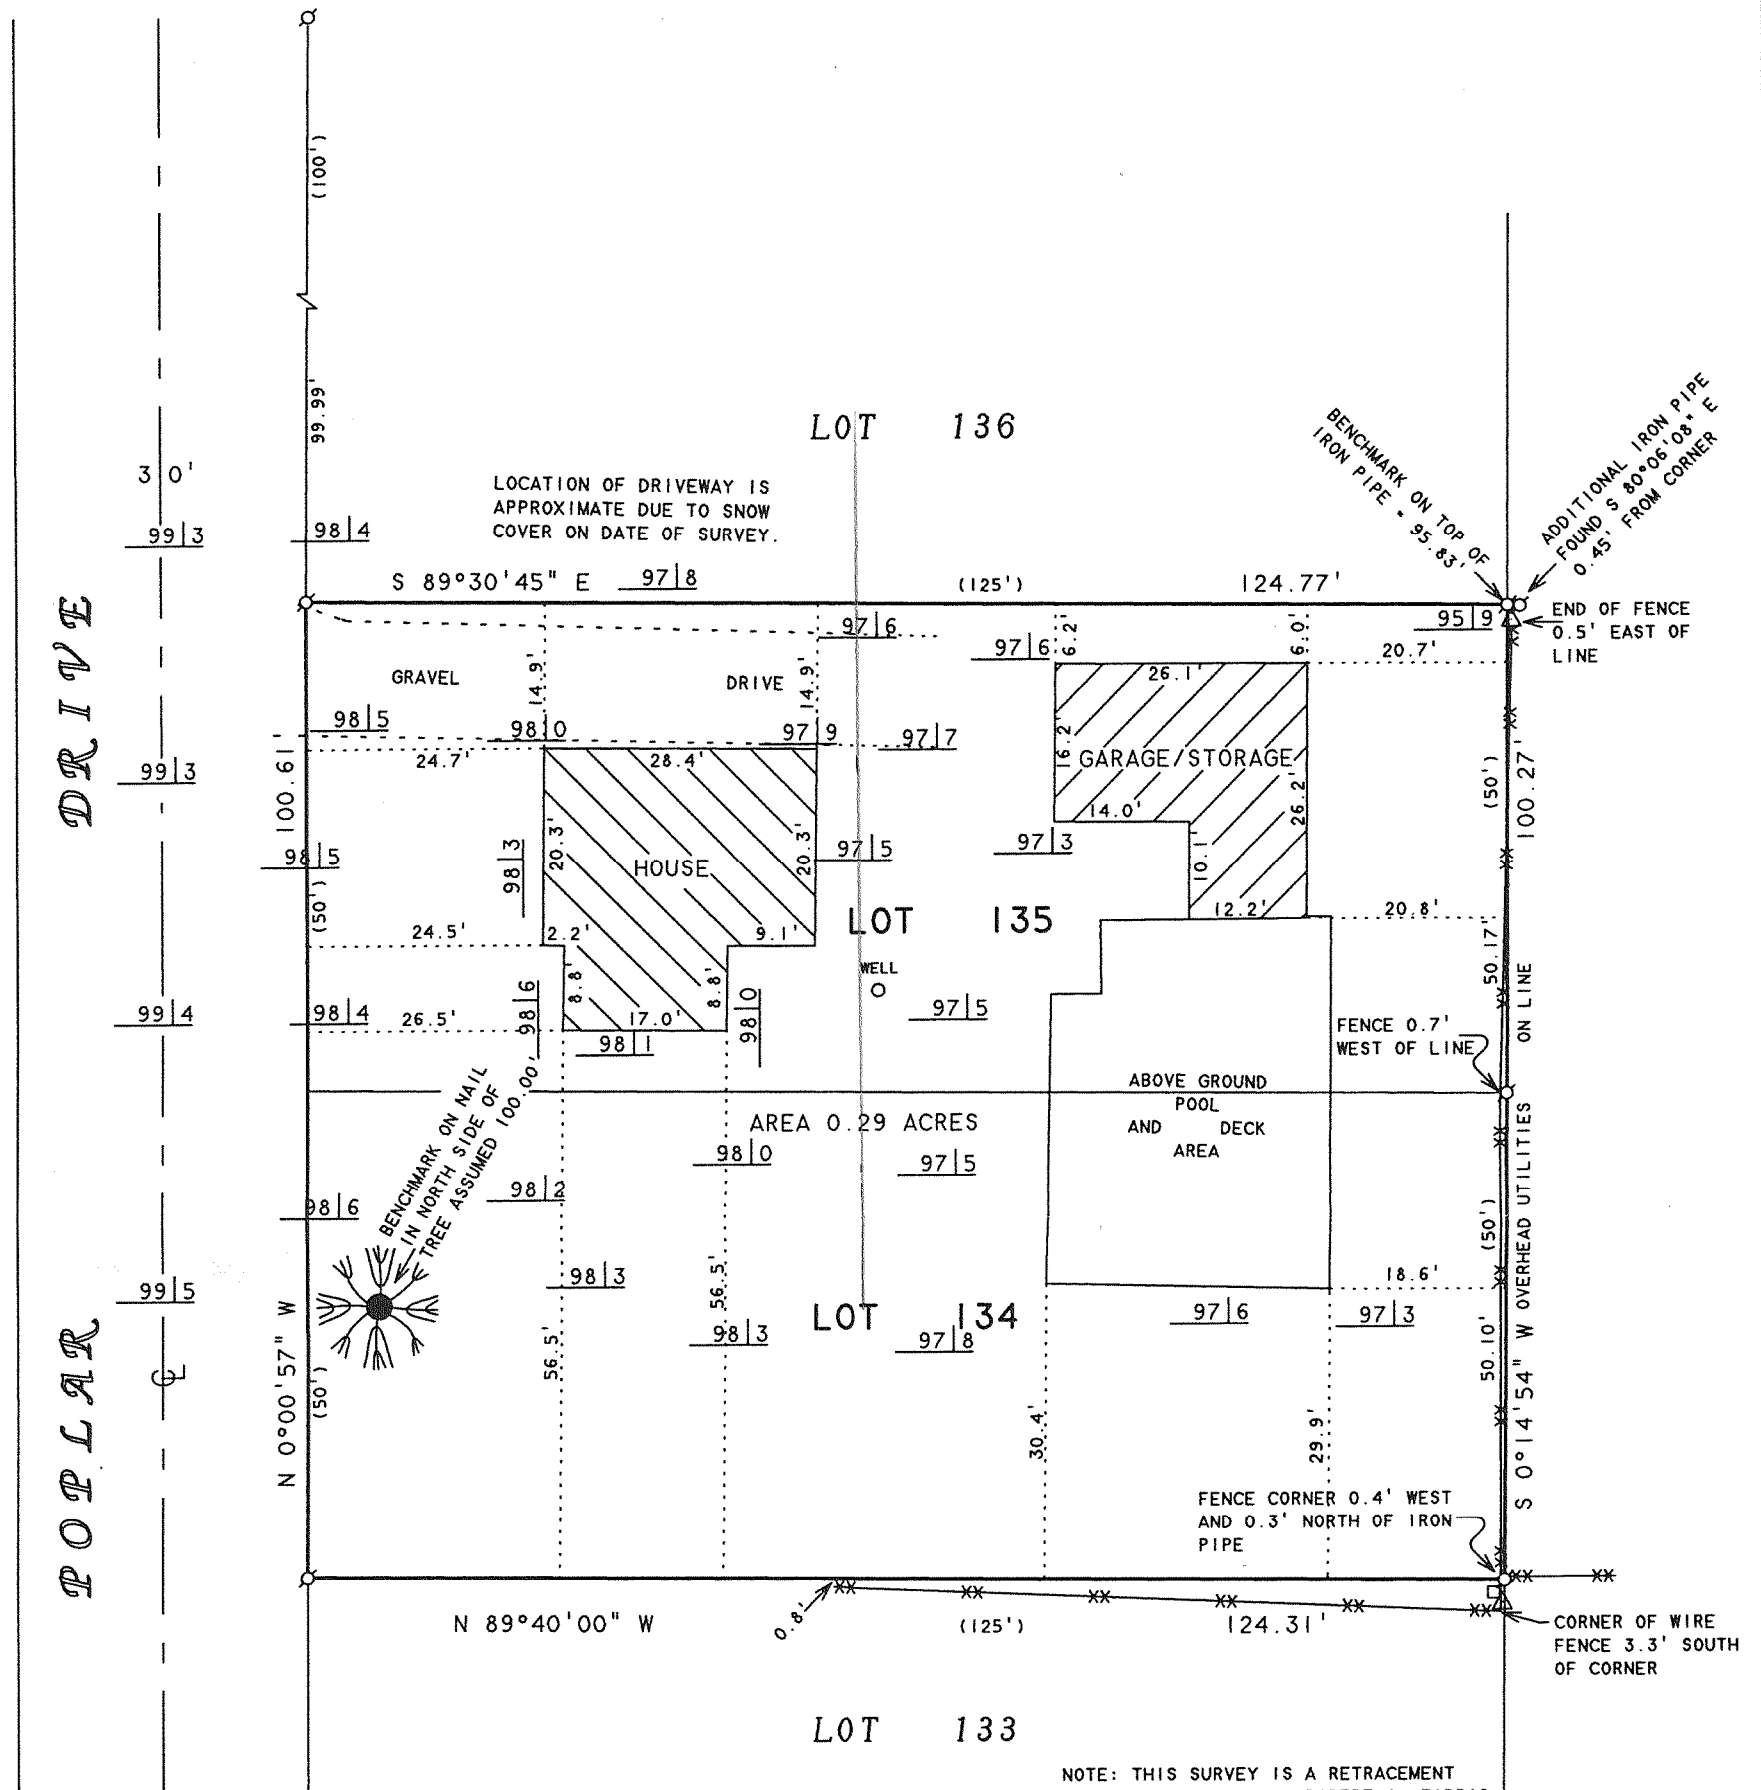

NOTE: BEARINGS ARE REFERENCED TO EXISTING SURVEY RECORDS.

NOTE: THIS SURVEY IS A RETRACEMENT OF A SURVEY BY ROBERT A. FARRIS DATED 12 JUNE 1979 AND REVISED 26 JUNE 1979.



SCALE 1" = 20'

**LEGEND**

- ⊙ - IRON PIPE FOUND
- △ - UTILITY POLE
- - UTILITY PED.
- XX - WIRE FENCE
- 99|6 - SPOT ELEVATION
- ( ) - RECORDED AS

ORDERED BY: MIKE EGLITE  
4231 POPLAR DRIVE  
DELAVAN, WI 53115


I, DAVID F. ABELL, DO HEREBY CERTIFY THAT I HAVE SURVEYED THE PROPERTY HEREON DESCRIBED ACCORDING TO THE OFFICAL RECORDS AND THAT THE PLAT HEREON IS A CORRECT REPRESENTATION OF THE PROPERTY LINES TO THE BEST OF MY KNOWLEDGE AND BELIEF.

*David F. Abell*  
DAVID F. ABELL  
WISCONSIN REGISTERED LAND SURVEYOR. S-1596

*February 22, 2007*

DATE: February 22, 2007 JOB NUMBER - 07003

NOTE: THIS IS NOT A CERTIFIED COPY UNLESS SEALED.

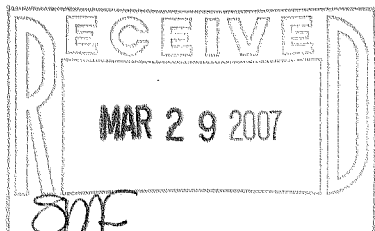

FLAD-109

216-4318