


# ABELL SURVEYING & MAPPING

1140 SEQUOIA STREET • DELAVAN, WISCONSIN 53115  
262-728-6737

DRIVE

POPLAR

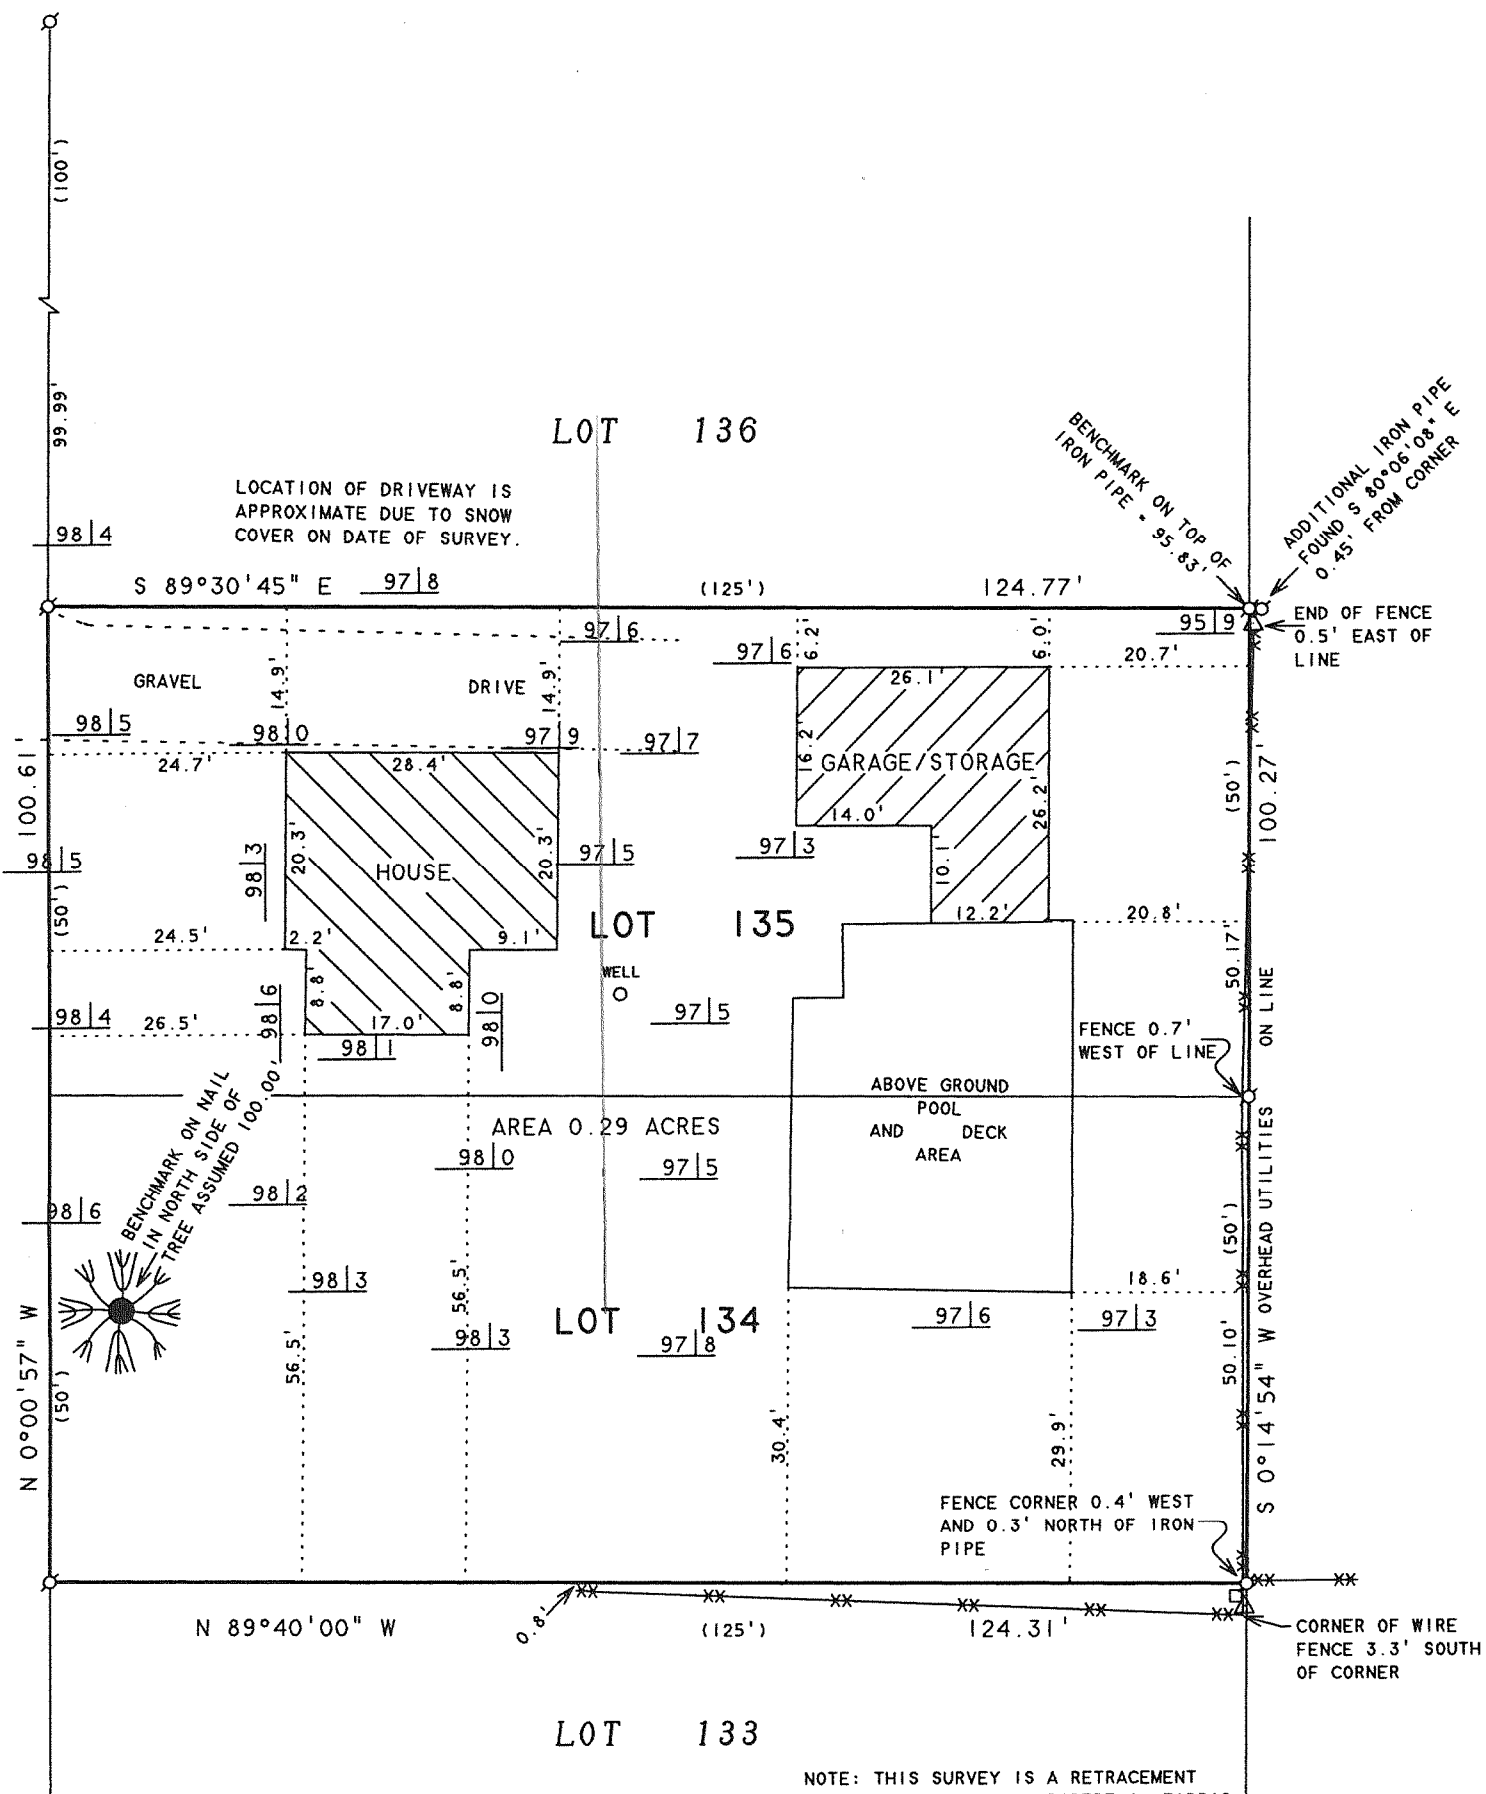

NOTE: BEARINGS ARE REFERENCED TO EXISTING SURVEY RECORDS.

N




SCALE 1"=20'

LEGEND

- - IRON PIPE FOUND
- △ - UTILITY POLE
- - UTILITY PED.
- XX - WIRE FENCE
- 99.6 - SPOT ELEVATION
- ( ) - RECORDED AS

ORDERED BY: MIKE EGLITE  
4231 POPLAR DRIVE  
DELAVAN, WI 53115

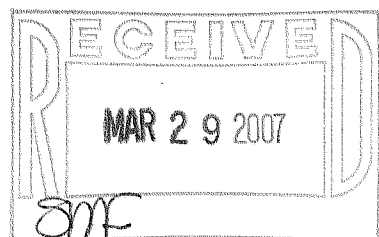

I, DAVID F. ABELL, DO HEREBY CERTIFY THAT I HAVE SURVEYED THE PROPERTY HEREON DESCRIBED ACCORDING TO THE OFFICAL RECORDS AND THAT THE PLAT HEREON IS A CORRECT REPRESENTATION OF THE PROPERTY LINES TO THE BEST OF MY KNOWLEDGE AND BELIEF.

*David F. Abell*

DAVID F. ABELL  
WISCONSIN REGISTERED LAND SURVEYOR, S-1596

February 22, 2007

DATE JOB NUMBER - 07003  
NOTE: THIS IS NOT A CERTIFIED COPY UNLESS SEALED.

FLAD-109

216-4318