
FARRIS, HANSEN & ASSOCIATES, INC.

ENGINEERING - ARCHITECTURE - SURVEYING 7 RIDGWAY COURT - P.O. BOX 437 - ELKHORN, WISCONSIN 53121 PHONE: (262) 723-2098 FAX: (262) 723-5886

- WORK ORDERED BY -JEFF CZARAPATA - CZAR CONSTRUCTION W5154 STEWART DRIVE ELKHORN, WI 53121

PLAT OF SURVEY

LOT 7 OF BLOCK 4 OF WOODLAWN BAY COMMUNITY LOCATED IN PART OF THE NW 1/4 OF THE NE 1/4 OF SECTION 28, TOWN 2 NORTH, RANGE 16 EAST,

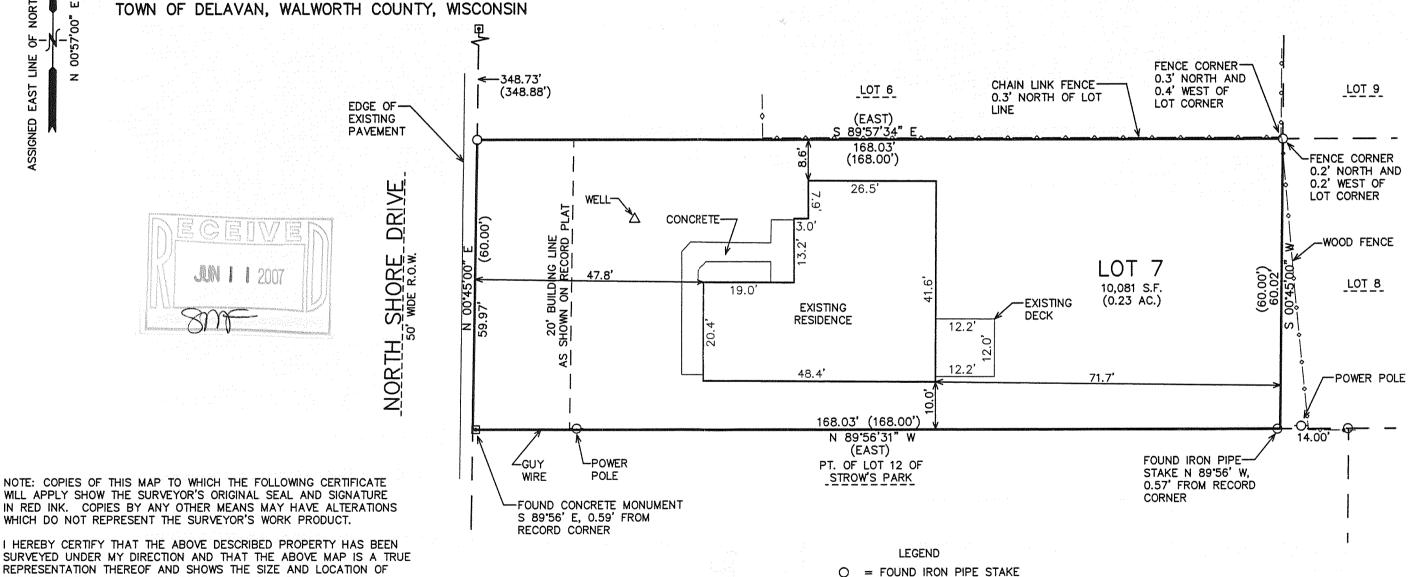

WILL APPLY SHOW THE SURVEYOR'S ORIGINAL SEAL AND SIGNATURE IN RED INK. COPIES BY ANY OTHER MEANS MAY HAVE ALTERATIONS WHICH DO NOT REPRESENT THE SURVEYOR'S WORK PRODUCT.

SURVEYED UNDER MY DIRECTION AND THAT THE ABOVE MAP IS A TRUE REPRESENTATION THEREOF AND SHOWS THE SIZE AND LOCATION OF THE PROPERTY AND ITS EXTERIOR BOUNDARIES. THIS SURVEY IS MADE FOR THE USE OF THE PRESENT OWNERS OF THE PROPERTY, AND ALSO THOSE WHO PURCHASE, MORTGAGE, OR GUARANTEE THE TITLE THERETO WITHIN ONE YEAR FROM THE DATE HEREOF.

DATED: JANUARY 30, 2006

DRIVE

SHORE

NORTH

유. LINE

EAST I

ASSIGNED

REVISED 04-28-2006 TO SHOW SIZE & LOCATION OF PROPOSED RESIDENCE REVISED 05-08-2007 TO SHOW SIZE AND LOCATION OF

EXISTING RESIDENCE

10 5 0

MAP SCALE IN FEET ORIGINAL 1" = 20'

= FOUND CONCRETE MONUMENT

(XXX) = RECORDED AS

PROJECT: 6972 DATE: 01/30/06 SHEET 1 OF 1

216-4356