


1140 SEQUOIA STREET • DELAVAN, WISCONSIN 53115
262-728-6737



LEGEND

- Ø - IRON PIPE FOUND
 ○ - IRON PIPE SET
 △ - UTILITY POLE
 — - OVERHEAD UTILITY LINES
 () - RECORDED AS

RECEIVED
JUL 18 2007
SMK

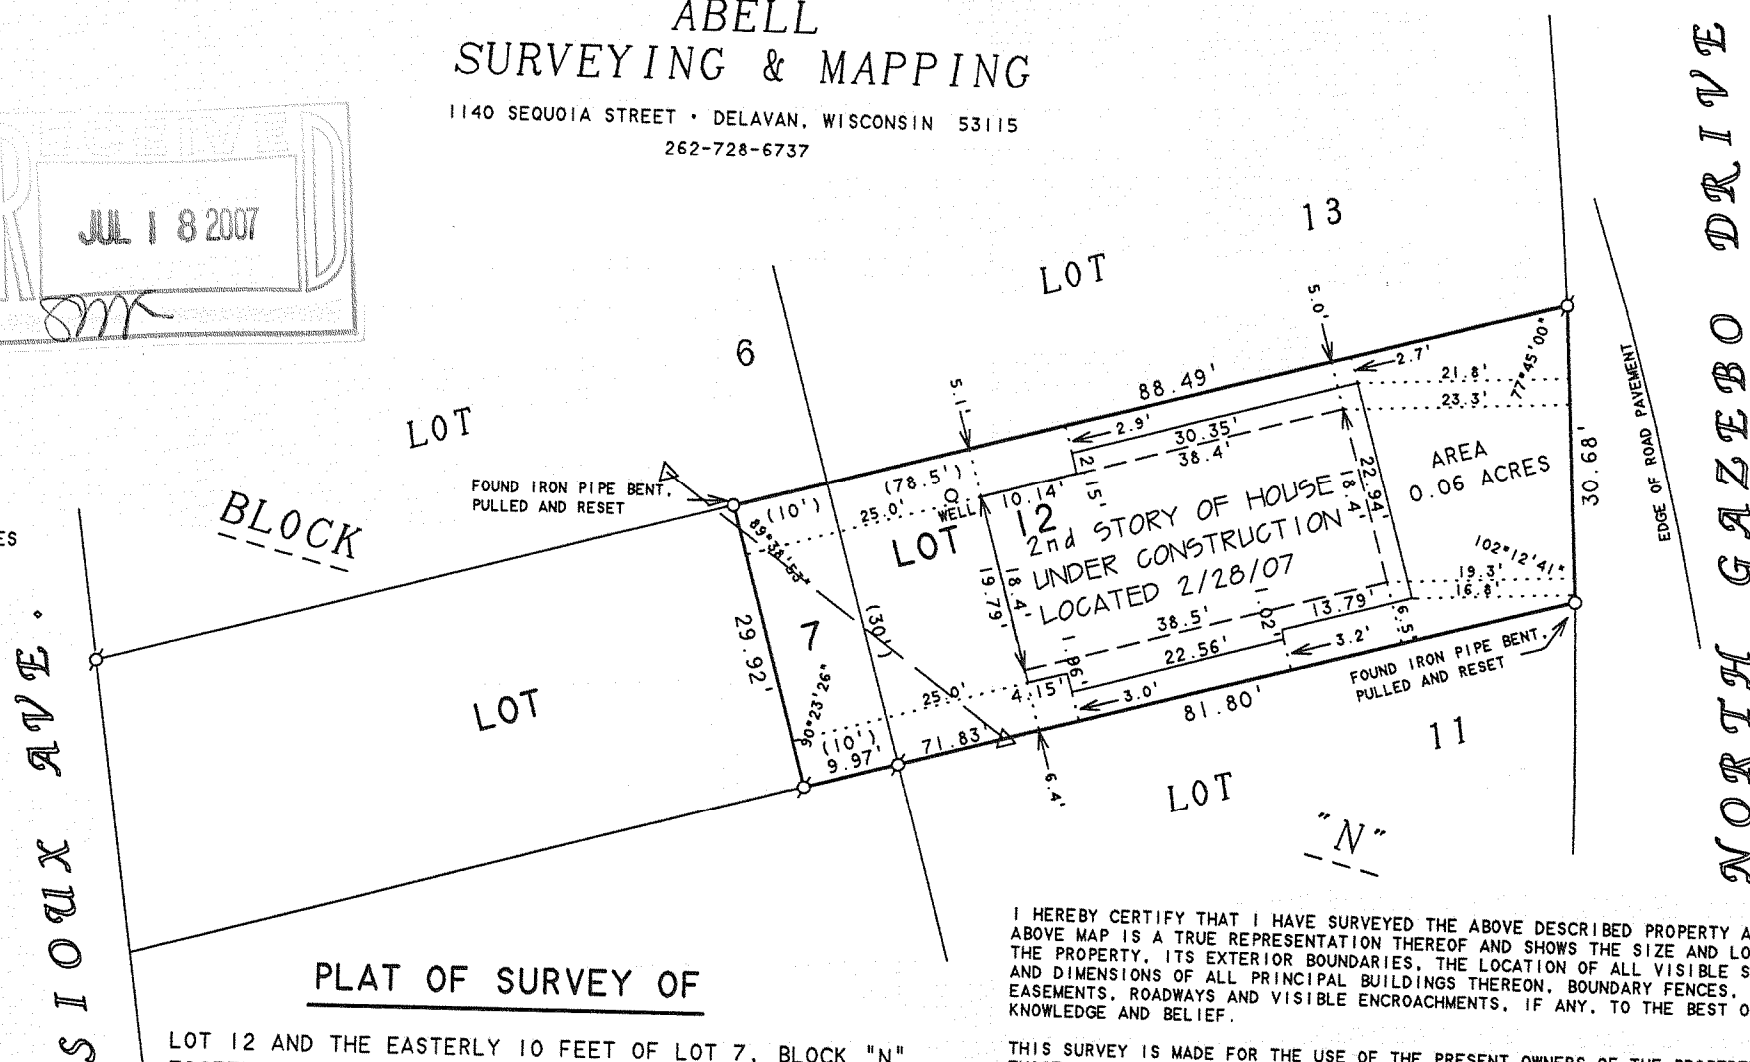

LOT 12 AND THE EASTERLY 10 FEET OF LOT 7, BLOCK "N",
TOGETHER WITH A RIGHT OF WAY , IN COMMON WITH OTHERS,
OVER LOT 6 IN BLOCK "N". ALL BEING IN DELAVAN LAKE
ASSEMBLY GROUNDS, A SUBDIVISION IN THE TOWN OF DELAVAN,
WALWORTH COUNTY, WISCONSIN.

I HEREBY CERTIFY THAT I HAVE SURVEYED THE ABOVE DESCRIBED PROPERTY AND THAT THE ABOVE MAP IS A TRUE REPRESENTATION THEREOF AND SHOWS THE SIZE AND LOCATION OF THE PROPERTY, ITS EXTERIOR BOUNDARIES, THE LOCATION OF ALL VISIBLE STRUCTURES AND DIMENSIONS OF ALL PRINCIPAL BUILDINGS THEREON, BOUNDARY FENCES, APPARENT EASEMENTS, ROADWAYS AND VISIBLE ENCROACHMENTS, IF ANY, TO THE BEST OF MY KNOWLEDGE AND BELIEF.

THIS SURVEY IS MADE FOR THE USE OF THE PRESENT OWNERS OF THE PROPERTY, AND ALSO THOSE WHO PURCHASE, MORTGAGE, OR GUARANTEE THE TITLE THERETO WITHIN ONE (1) YEAR FROM DATE HEREON.

David F. Bell

DAVID F. ABELL
WISCONSIN REGISTERED LAND SURVEYOR, S-1596

ORDERED BY: MARTIN CONSTRUCTION
867 COMUS DRIVE
DELAVER, WI 53115

April 20, 2007

DATE: _____ JOB NUMBER - 96140D
NOTE: THIS IS NOT A CERTIFIED COPY UNLESS SEALED.

216-4379

FDLA - 139