


PREPARED FOR
RE/MAX GENEVA REALTY, LTD
C/O JOE SCHULTZ
101 BROAD ST. SUITE 102
LAKE GENEVA WI. 53147

PLAT OF SURVEY

- OF -

LOTS 130 AND 131 OF KRUMHAAR'S SECOND ADDITION TO
RAVENSWOOD, A SUBDIVISION LOCATED IN THE NORTHWEST
1/4 OF THE SOUTHEAST 1/4 OF SECTION 31, TOWN 2 NORTH,
RANGE 16 EAST, WALWORTH COUNTY, WISCONSIN.

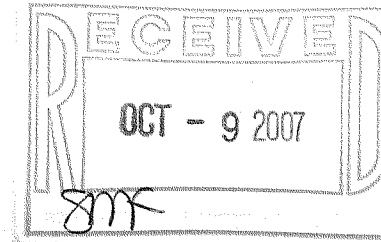

PATHFINDER SURVEYING INC.
W2888 KRUEGER RD. UNIT "D"
LAKE GENEVA WI. 53147
(262) 248-3697

(20' WIDE)

RAVENSWOOD DRIVE

(20' WIDE)

MASCHE DRIVE

39.93'

(80.00')

160.55'

FOUND P.K. NAIL

FOUND IRON T POST
ONLINE 0.75' EAST OF CORNER

(120.00')
N 90°00'00" E 120.25'

46.06'

17.84'

(120.00')
S 90°00'00" E 119.15'

101.31'

LOT 136

EXISTING GARAGE

LOT 131

N 00°36'59" W
(80.00')

31.5'

79.85'

OVERHEAD WIRES

POWER POLE

LOT 137

LOT 130

FOUND 10" SPIKE AT CORNER

S 89°53'25" W 120.17'
(120.00')


S 89°56'08" W 119.49'
(120.00')

40.21'

120.24'

FOREST DRIVE

(20' WIDE)

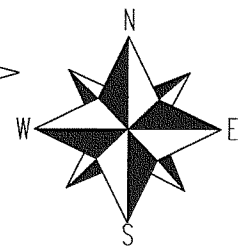

× = IRON T POST FOUND

() = recorded as

□ = found iron bar

○ = found iron pipe

■ = set iron bar

SCALE 1" = 20'

JOB # 07-359

TAX ID # FRA200024

COMPARE LEGAL DESCRIPTION ABOVE AND DRAWING WITH DEED. FOR BUILDING RESTRICTIONS AND
EASEMENTS NOT SHOWN, REFER TO DEED, ABSTRACT SOURCES AND LOCAL MUNICIPAL CODES. NOTIFY
THE SURVEYOR IMMEDIATELY OF ANY DISCREPANCY.

"I hereby certify that I have surveyed the above described property and that
the above map, to the best of my knowledge and belief, is a true representation
thereof and shows the size and location of all visible structures, apparent
easements and encroachments if any."
This survey is made for the present owners of the property, and those who
purchase, mortgage, or guarantee the title thereto, within one year from
the date hereof

John P. Krott

JOHN KROTT S - 2258
Wisconsin Registered Land Surveyor
(original if signed in red)

DATED THIS THE 14th DAY OF AUGUST 2007.

216-4429