



PREPARED FOR:
DONALD C. STINESPRING & ASSOCIATES
P.O. BOX 382
RICHMAOND, IL 60071
815-678-4553

PLAT OF SURVEY

-OF-

PATHFINDER SURVEYING, INC.
W2888 KRUEGER ROAD UNIT "D"
LAKE GENEVA, WI 53147
(262) 248-3697

LOT 30 OF HIGH POINTE ADDITION No. 1, BEING A REDIVISION
OF OUTLOT 2, "HIGH POINTE," BEING A PART OF THE SOUTHEAST
1/4 AND THE SOUTHWEST 1/4 OF THE SOUTHEAST 1/4 OF SECTION
20 AND PART OF THE SOUTHWEST 1/4 OF THE SOUTHWEST 1/4 OF
SECTION 21, TOWN 2 NORTH, RANGE 16 EAST IN THE TOWN OF
DELAN, WALWORTH COUNTY, WISCONSIN.

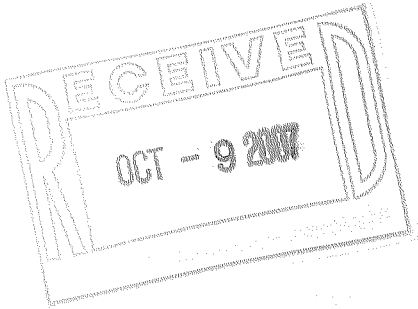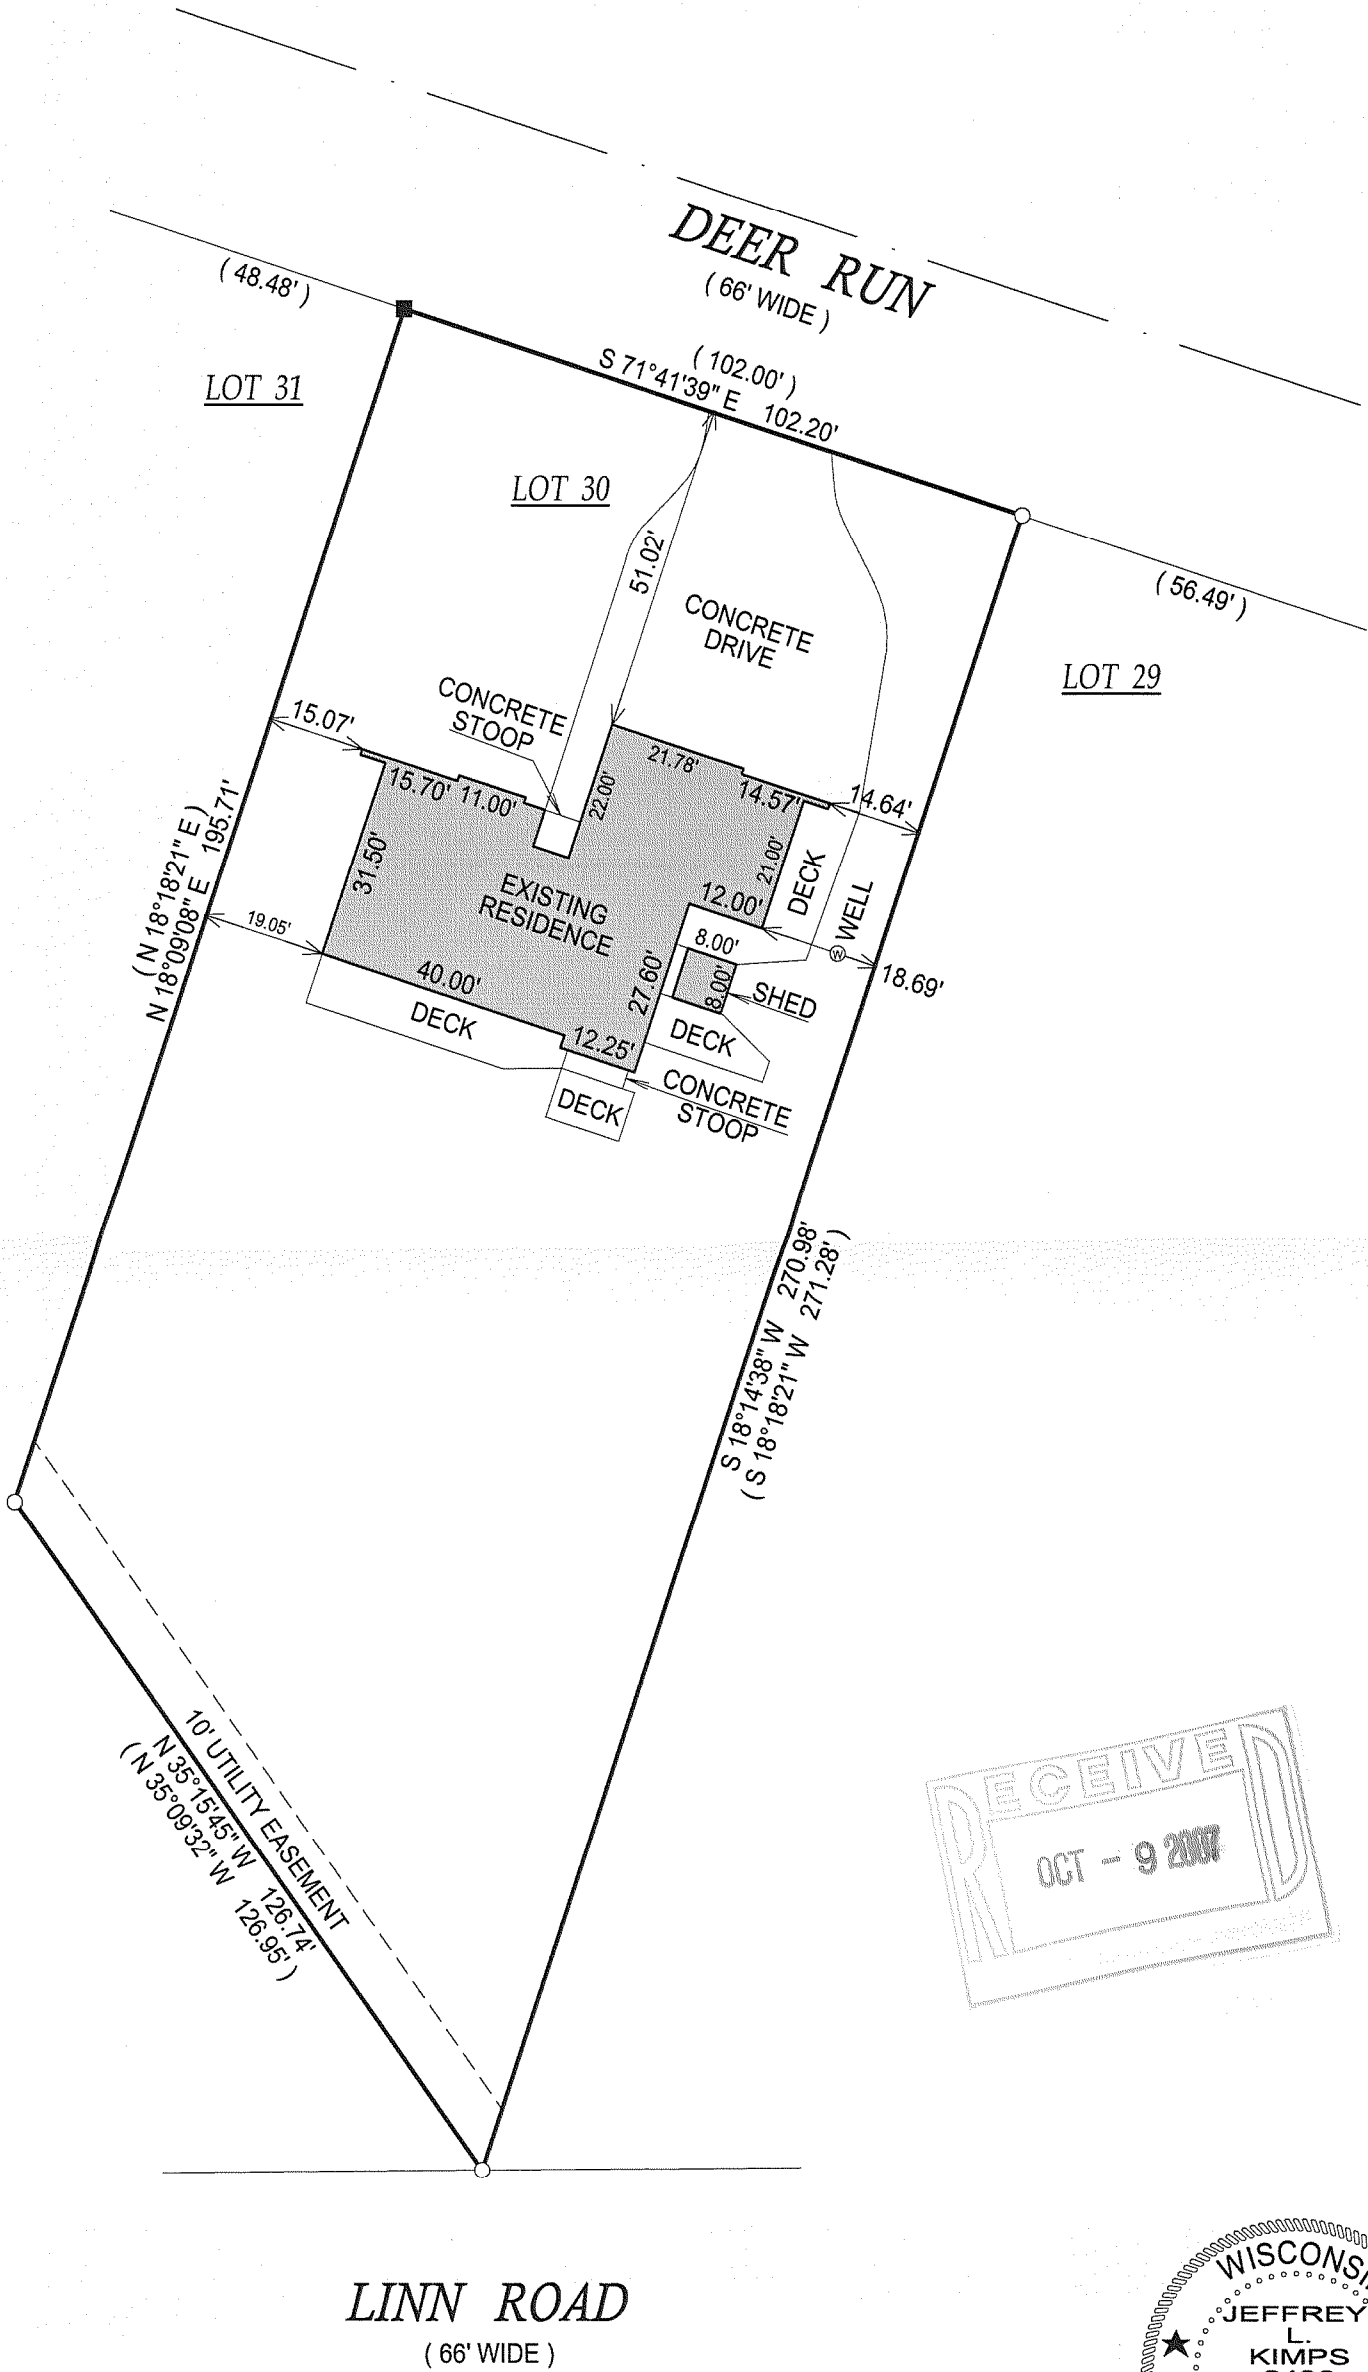

() = RECORDED AS
□ = FOUND IRON BAR
○ = FOUND IRON PIPE
■ = SET IRON BAR
● = SET IRON PIPE
SCALE: 1" = 30'
JOB #: 07-367
TAX ID #: FHP1 00015

NOTE: BASIS OF BEARING IS RECORD PLAT.
COMPARE LEGAL DESCRIPTION ABOVE AND DRAWING WITH DEED. FOR BUILDING RESTRICTIONS AND
EASEMENTS NOT SHOWN, REFER TO DEED, ABSTRACT SOURCES AND LOCAL MUNICIPAL CODES. NOTIFY
THE SURVEYOR IMMEDIATELY OF ANY DISCREPANCY.
"I hereby certify that the above described property was surveyed under my
supervision and that the above map, to the best of my knowledge and
belief, is a true representation thereof and shows the size and location of all
visible structures, apparent easements and encroachments if any."
This survey is made for the present owners of the property, and those who
purchase, mortgage, or guarantee the title thereto, within one year from
the date hereof.

JEFFREY L. KIMPS S-2436
Wisconsin Registered Land Surveyor
(original if signed in red)
DATED THIS 21st DAY OF AUGUST, 2007.

216 -