
ABELL SURVEYING & MAPPING

1140 SEQUOIA STREET • DELAYAN, WISCONSIN 53115 262-728-6737



BEARINGS ARE REFERENCED TO THE RECORDED SUBDIVISION PLAT.



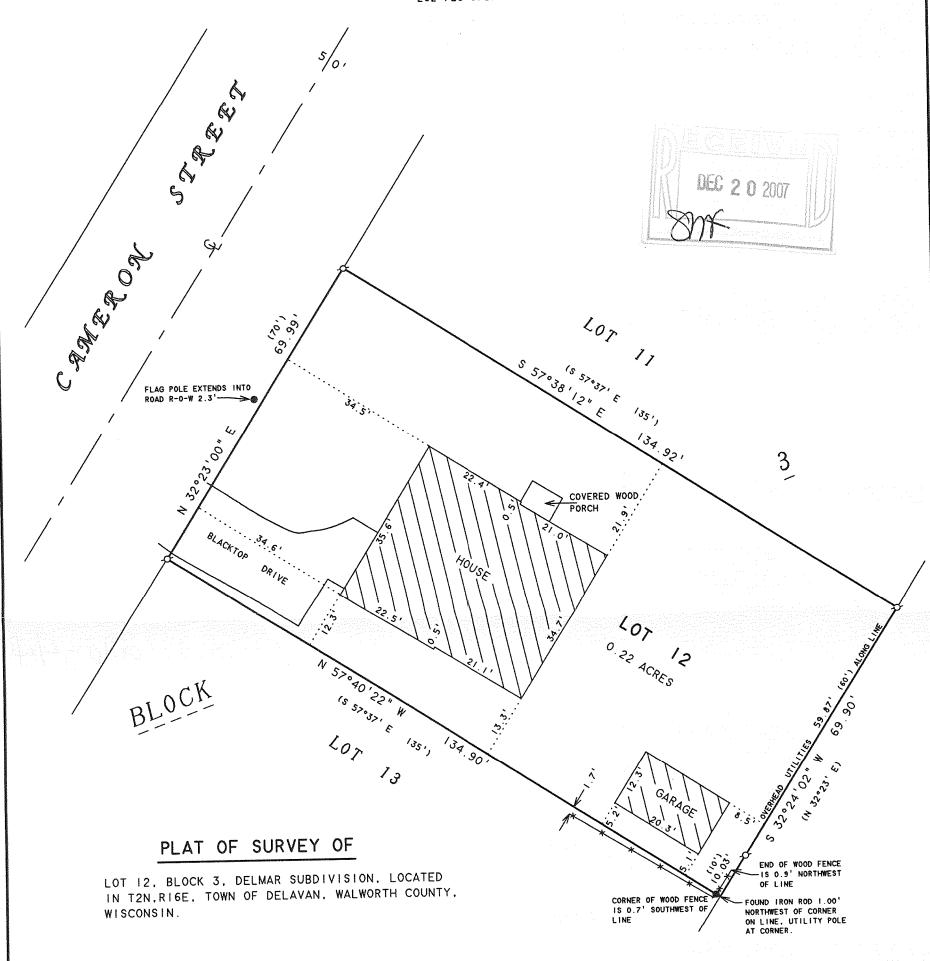

SCALE | "=20'

LEGEND

ORDERED BY: SHOREWEST REALTORS 830 E. GENEVA STREET DELAVAN, WI 53115

I HEREBY CERTIFY THAT I HAVE SURVEYED THE ABOVE DESCRIBED PROPERTY AND THAT THE ABOVE MAP IS A TRUE REPRESENTATION THEREOF AND SHOWS THE SIZE AND LOCATION OF THE PROPERTY. ITS EXTERIOR BOUNDARIES, THE LOCATION OF ALL VISIBLE STRUCTURES AND DIMENSIONS OF ALL PRINCIPAL BUILDINGS THEREON, BOUNDARY FENCES, APPARENT EASEMENTS, ROADWAYS AND VISIBLE ENCROACHMENTS, IF ANY, TO THE BEST OF MY KNOWLEDGE AND BELIEF.

THIS SURVEY IS MADE FOR THE USE OF THE PRESENT OWNERS OF THE PROPERTY. AND ALSO THOSE WHO PURCHASE, MORTGAGE, OR GUARANTEE THE TITLE THERETO WITHIN ONE (I) YEAR FROM DATE HEREON.

Land t. Ghl

DAVID F. ABELL WISCONSIN REGISTERED LAND SURVEYOR, S-1596

November 1, 2007

JOB NUMBER - 07076

DATE JOB NUMBER - NOTE: THIS IS NOT A CERTIFIED COPY UNLESS SEALED.

FDM - 18A

216-4490