
ABELL SURVEYING & MAPPING

1140 SEQUOTA STREET - DELAVAN. WISCONSIN 53115 262-728-6737



PLAT OF SURVEY OF

LOT 4, BLOCK I, POTTERS SUBDIVISION, LOCATED IN TOWN 2 NORTH, RANGE 16 EAST, WALWORTH COUNTY, WISCONSIN.

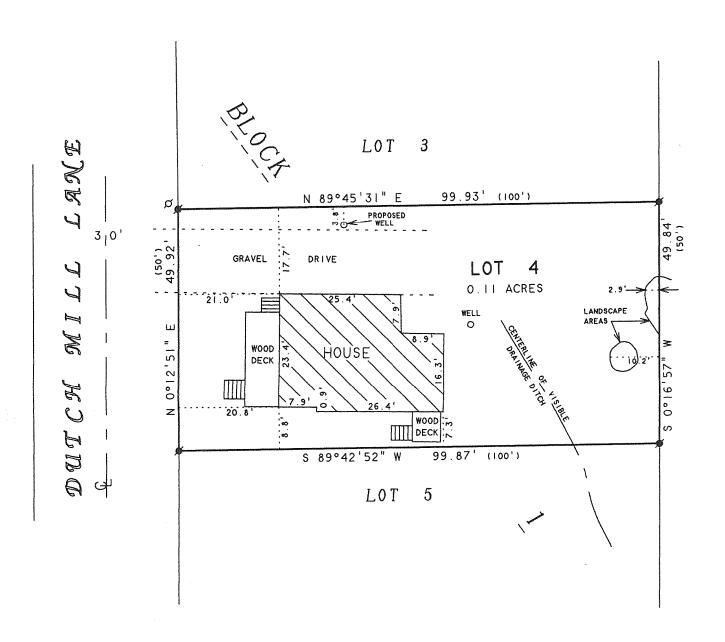

BEARINGS ARE REFERENCED TO EXISTING SURVEY RECORDS.





SCALE | " = 20

LEGEND

Ø - IRON PIPE FOUND Ø - IRON ROD FOUND () - RECORDED AS ORDERED BY: DELORES PIERCE 3139 S. GROVE AVENUE BERWIN, IL 60402

I HEREBY CERTIFY THAT I HAVE SURVEYED THE ABOVE DESCRIBED PROPERTY AND THAT THE ABOVE MAP IS A TRUE REPRESENTATION THEREOF AND SHOWS THE SIZE AND LOCATION OF THE PROPERTY. ITS EXTERIOR BOUNDARIES. THE LOCATION OF ALL VISIBLE STRUCTURES AND DIMENSIONS OF ALL PRINCIPAL BUILDINGS THEREON, BOUNDARY FENCES. APPARENT EASEMENTS, ROADWAYS AND VISIBLE ENCROACHMENTS, IF ANY, TO THE BEST OF MY KNOWLEDGE AND BELIEF.

THIS SURVEY IS MADE FOR THE USE OF THE PRESENT OWNERS OF THE PROPERTY, AND ALSO THOSE WHO PURCHASE, MORTGAGE, OR GUARANTEE THE TITLE THERETO WITHIN ONE (I) YEAR FROM DATE HEREON.

DAVID F. ABELL

DAVID F. ABELL WISCONSIN REGISTERED LAND SURVEYOR, S-1596

September 24, 2008

DATE JOB NUMBER - 89072A

NOTE: THIS IS NOT A CERTIFIED COPY UNLESS SEALED.

216-4605

FP0-4