


ABELL SURVEYING & MAPPING


1140 SEQUOIA STREET • DELAVAN, WISCONSIN 53115
262-728-6737

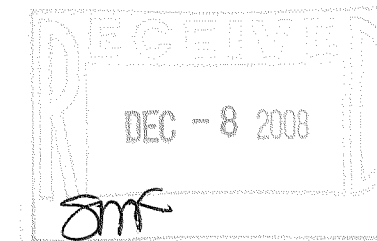

NOTE: BEARINGS ARE REFERENCED TO
EXISTING SURVEY RECORDS.

PLAT OF SURVEY OF

LOT 1 EXCEPT A FIFTEEN FOOT STRIP ALONG THE
SOUTHERLY LINE OF LOT 1 EXTENDING FROM THE
HIGHWAY TO THE LAKE IN THE BRINK SUBDIVISION
ACCORDING TO THE RECORDED PLAT THEREOF, LOCATED
IN SECTION 27, T2N, R16E, TOWN OF DELAVAN,
WALWORTH COUNTY, WISCONSIN.

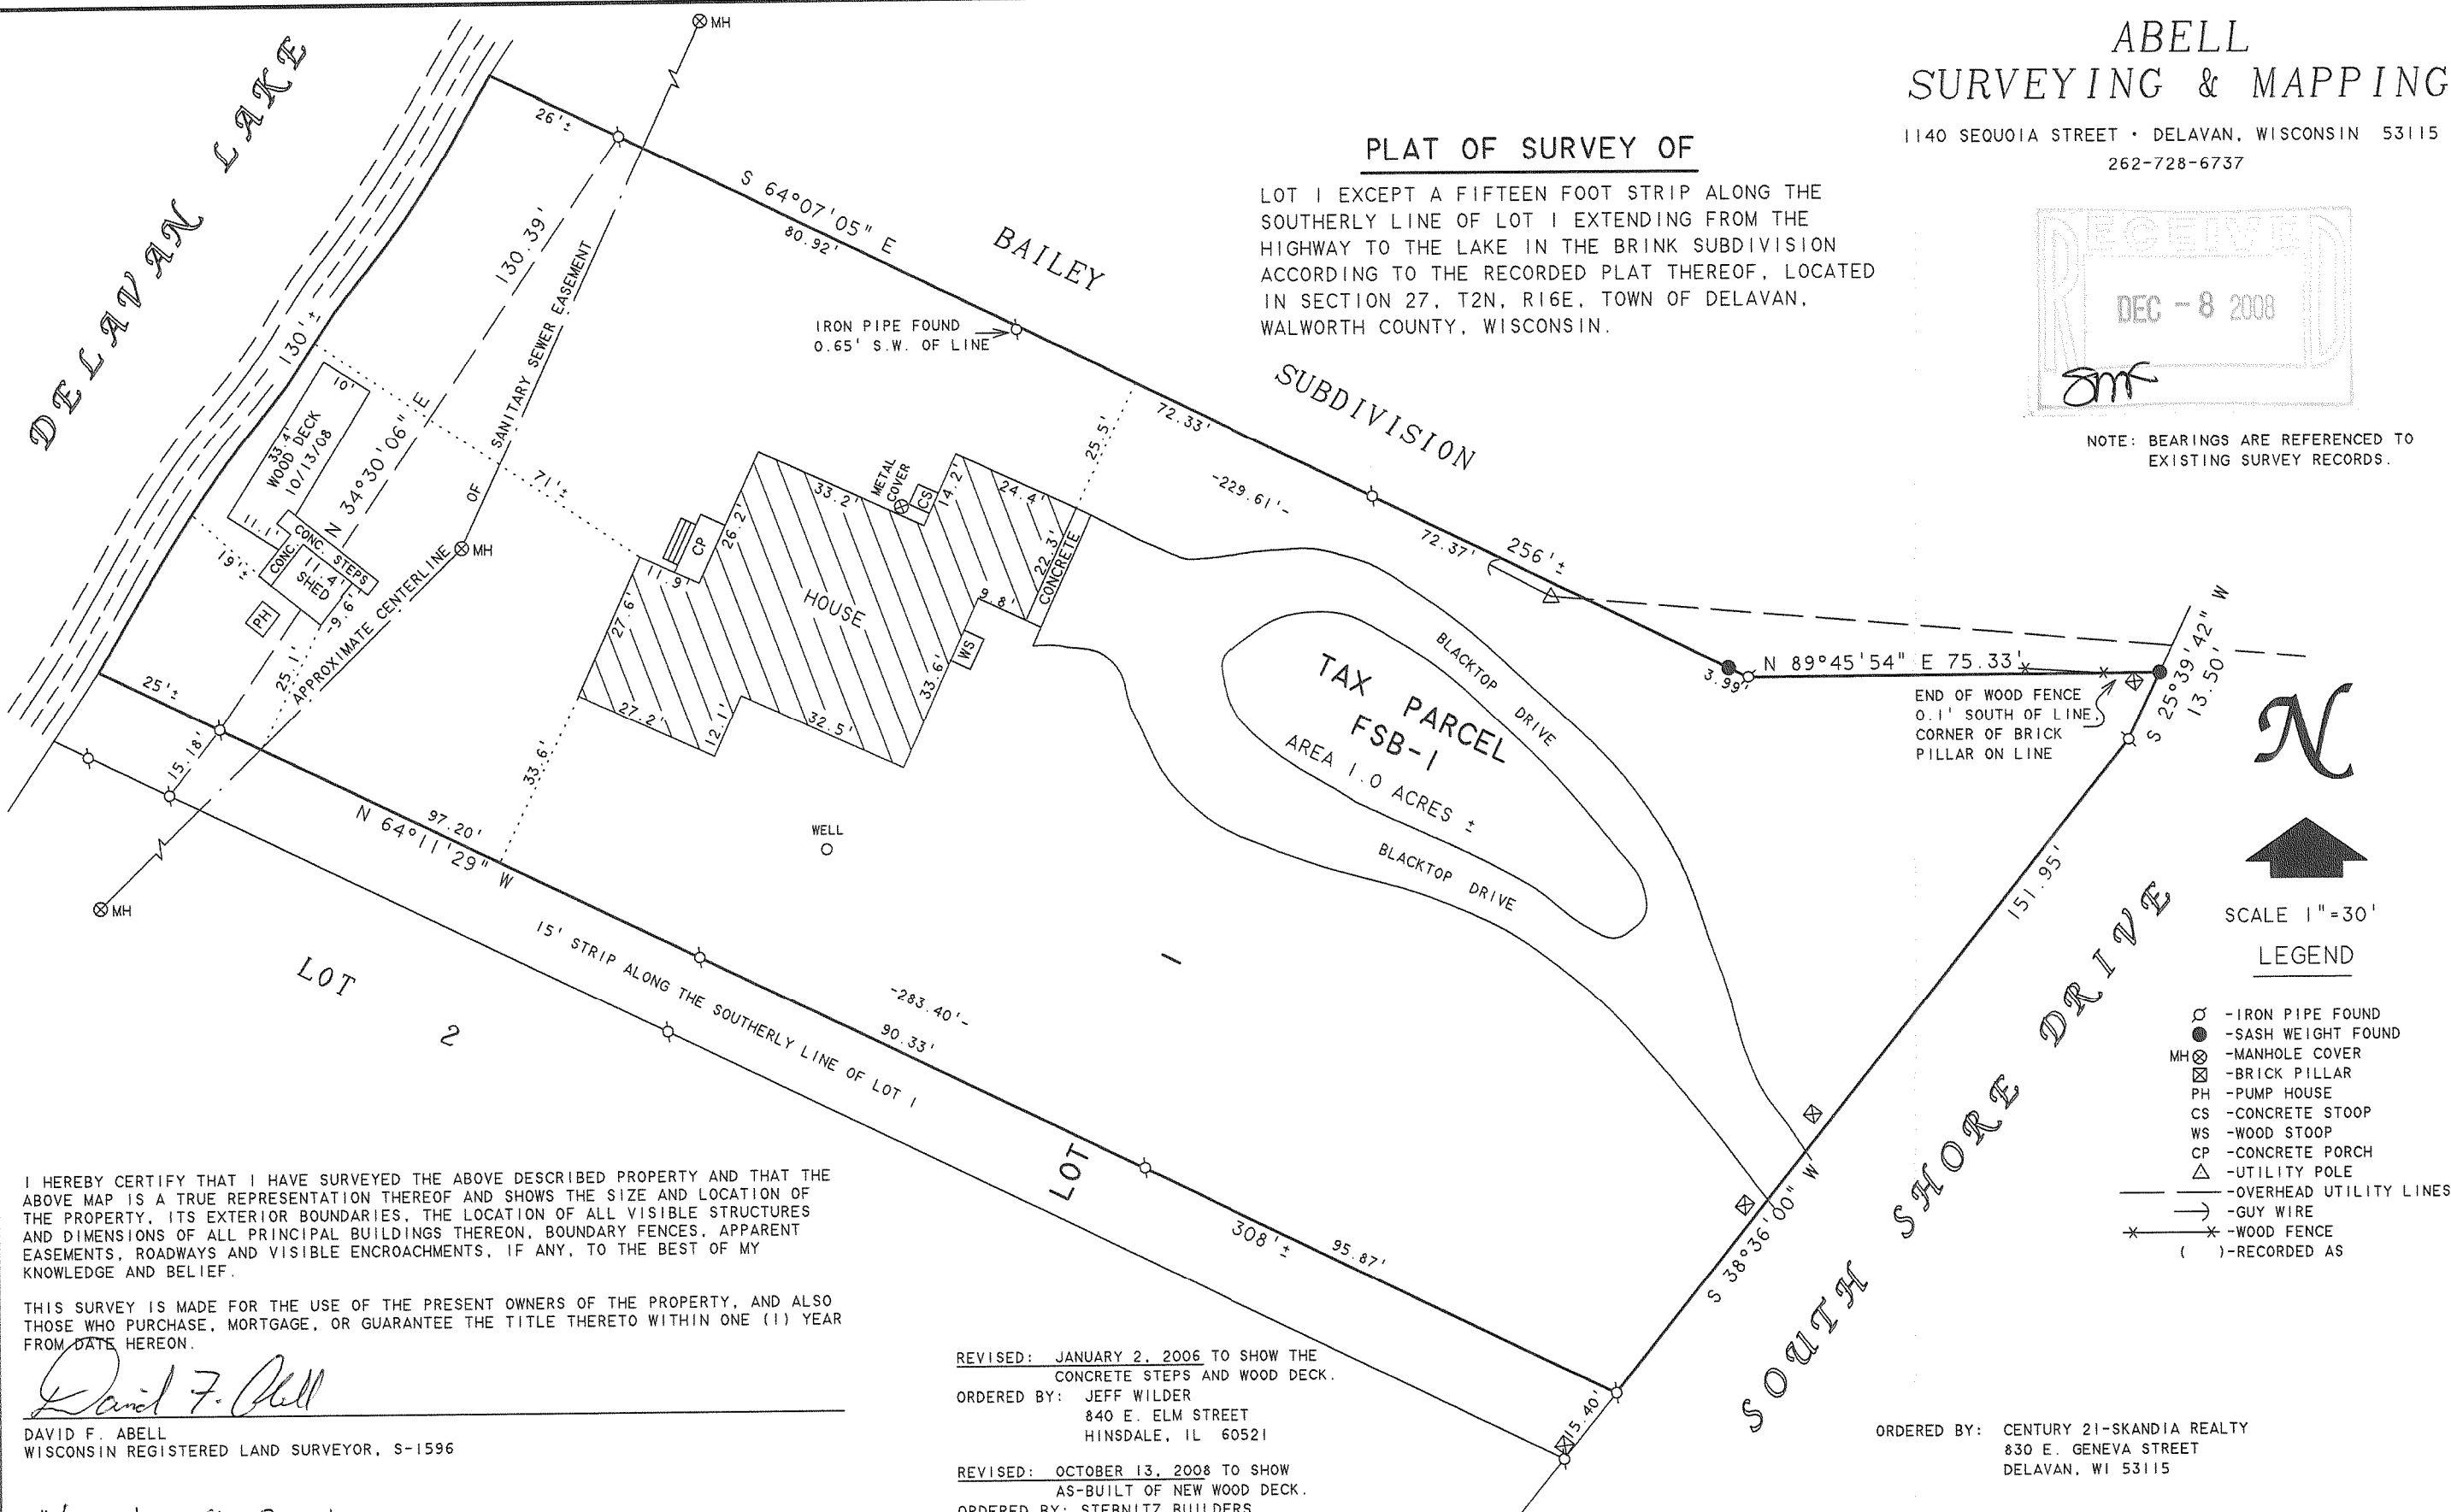

I HEREBY CERTIFY THAT I HAVE SURVEYED THE ABOVE DESCRIBED PROPERTY AND THAT THE
ABOVE MAP IS A TRUE REPRESENTATION THEREOF AND SHOWS THE SIZE AND LOCATION OF
THE PROPERTY, ITS EXTERIOR BOUNDARIES, THE LOCATION OF ALL VISIBLE STRUCTURES
AND DIMENSIONS OF ALL PRINCIPAL BUILDINGS THEREON, BOUNDARY FENCES, APPARENT
EASEMENTS, ROADWAYS AND VISIBLE ENCROACHMENTS, IF ANY, TO THE BEST OF MY
KNOWLEDGE AND BELIEF.

THIS SURVEY IS MADE FOR THE USE OF THE PRESENT OWNERS OF THE PROPERTY, AND ALSO
THOSE WHO PURCHASE, MORTGAGE, OR GUARANTEE THE TITLE THERETO WITHIN ONE (1) YEAR
FROM DATE HEREON.

David F. Abell

DAVID F. ABELL
WISCONSIN REGISTERED LAND SURVEYOR, S-1596

November 8, 2004

DATE: November 8, 2004 JOB NUMBER - 04138B
NOTE: THIS IS NOT A CERTIFIED COPY UNLESS SEALED.

REVISED: JANUARY 2, 2006 TO SHOW THE
CONCRETE STEPS AND WOOD DECK.
ORDERED BY: JEFF WILDER
840 E. ELM STREET
HINSDALE, IL 60521

REVISED: OCTOBER 13, 2008 TO SHOW
AS-BUILT OF NEW WOOD DECK.
ORDERED BY: STEBNITZ BUILDERS
P.O. BOX 526
DELAVAN, WI 53115

ORDERED BY: CENTURY 21-SKANDIA REALTY
830 E. GENEVA STREET
DELAVAN, WI 53115

FBS-1

216-4608