


ABELL
SURVEYING & MAPPING

LOT 76

1140 SEQUOIA STREET • DELAVAN, WISCONSIN 53115
262-728-6737

BENCHMARK ON TOP OF
IRON PIPE = 930.65'

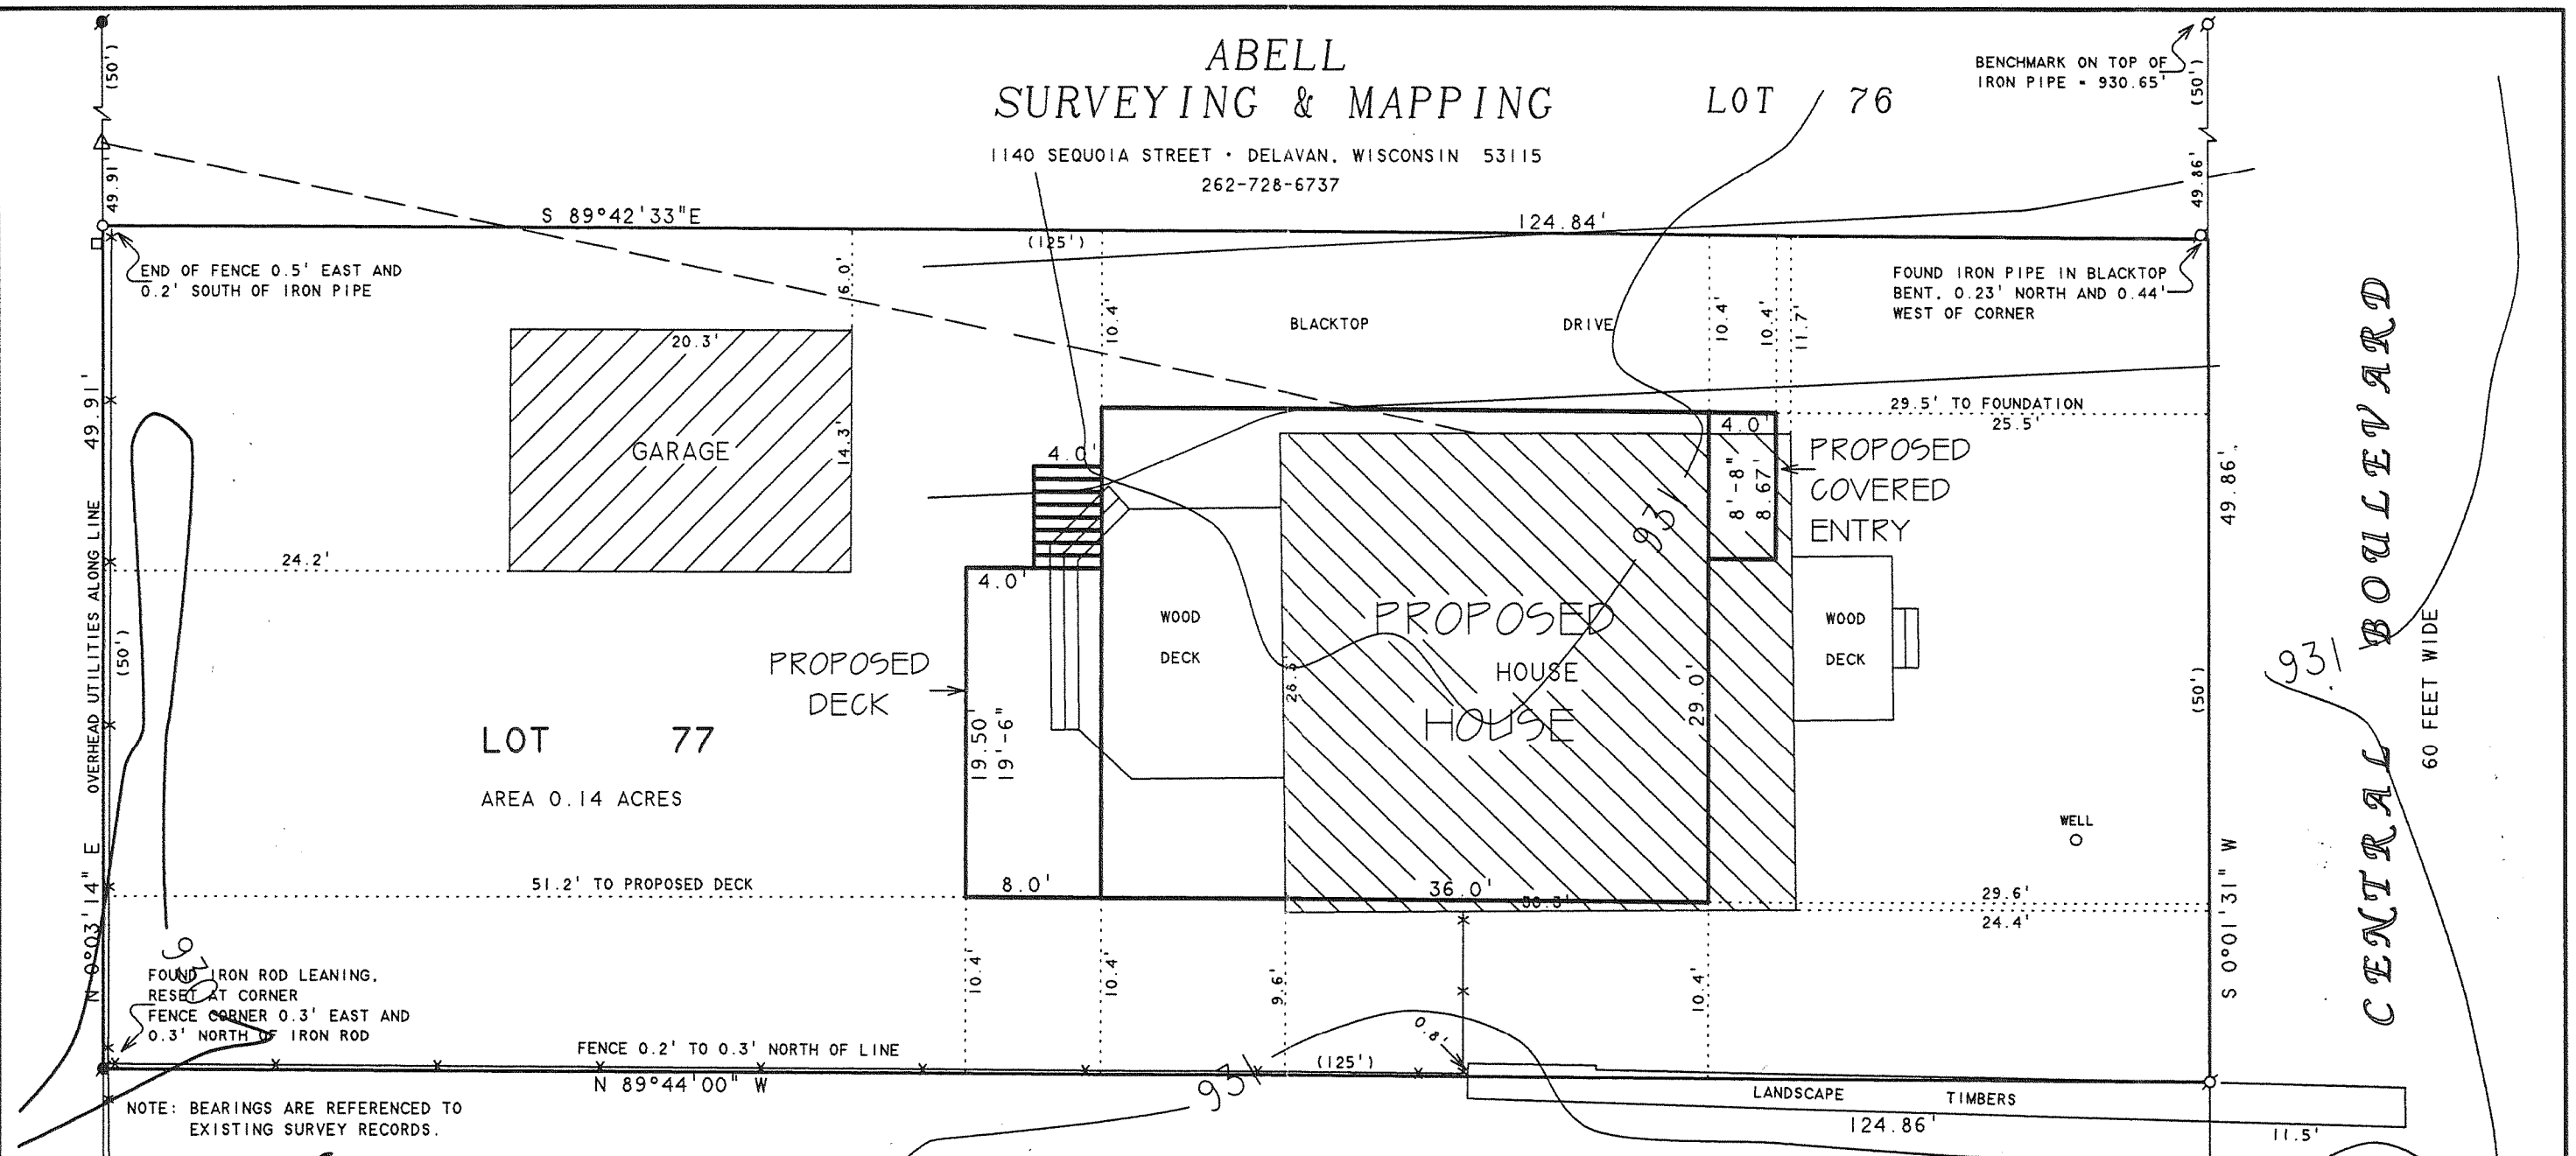

LOT 77
AREA 0.14 ACRES

LOT 78

NOTE: LOT 77 DOES NOT FALL WITHIN
THE FLOODPLAIN OF DELAVAN LAKE.

ELEVATIONS REFERENCED TO USGS NATIONAL
WATER INFORMATION SYSTEM FOR DELAVAN LAKE.
LAKE ELEVATION 927.96' ON OCTOBER 8, 2008
FLOODPLAIN FOR DELAVAN LAKE IS 929'.

I HEREBY CERTIFY THAT I HAVE SURVEYED THE ABOVE DESCRIBED PROPERTY AND THAT THE ABOVE MAP IS A TRUE REPRESENTATION THEREOF AND SHOWS THE SIZE AND LOCATION OF THE PROPERTY, ITS EXTERIOR BOUNDARIES, THE LOCATION OF ALL VISIBLE STRUCTURES AND DIMENSIONS OF ALL PRINCIPAL BUILDINGS THEREON, BOUNDARY FENCES, APPARENT EASEMENTS, ROADWAYS AND VISIBLE ENCROACHMENTS, IF ANY, TO THE BEST OF MY KNOWLEDGE AND BELIEF.

THIS SURVEY IS MADE FOR THE USE OF THE PRESENT OWNERS OF THE PROPERTY, AND ALSO THOSE WHO PURCHASE, MORTGAGE, OR GUARANTEE THE TITLE THERETO WITHIN ONE (1) YEAR FROM DATE HEREON.

David F. Abell
DAVID F. ABELL
WISCONSIN REGISTERED LAND SURVEYOR, S-1596

REVISED DATE: OCTOBER 16, 2008
REVISED TO SHOW NEW PROPOSED
HOUSE LOCATION.

ORDERED BY: HUGHES BUILDERS INC.
151 RUSH STREET
LAKE GENEVA, WI 53147


October 13, 2008
DATE
JOB NUMBER - 88087C
NOTE: THIS IS NOT A CERTIFIED COPY UNLESS SEALED.

NOTE: BEARINGS ARE REFERENCED TO
EXISTING SURVEY RECORDS.



SCALE 1" = 10'
LEGEND

- - IRON PIPE FOUND
- - IRON ROD FOUND
- - 1" DIA. IRON PIPE SET
- △ - UTILITY POLE
- — — - OVERHEAD UTILITY LINES
- - UTILITY PED
- * - CHAINLINK FENCE
- () - RECORDED AS

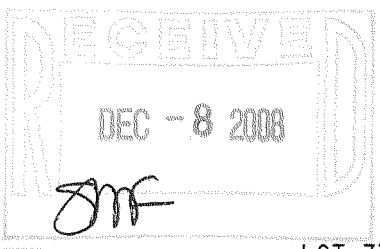

PLAT OF SURVEY OF

LOT 77, LAKE DELAVAN HIGHLANDS, LOCATED IN
T2N, R16E, TOWN OF DELAVAN, WALWORTH COUNTY,
WISCONSIN.

FLAD-666

216-4611