


NORTH SHORE DRIVE
(ST. JAMES AVENUE)

ABELL
SURVEYING & MAPPING
1140 SEQUOIA STREET • DELAVAN, WISCONSIN 53115
262-728-6737

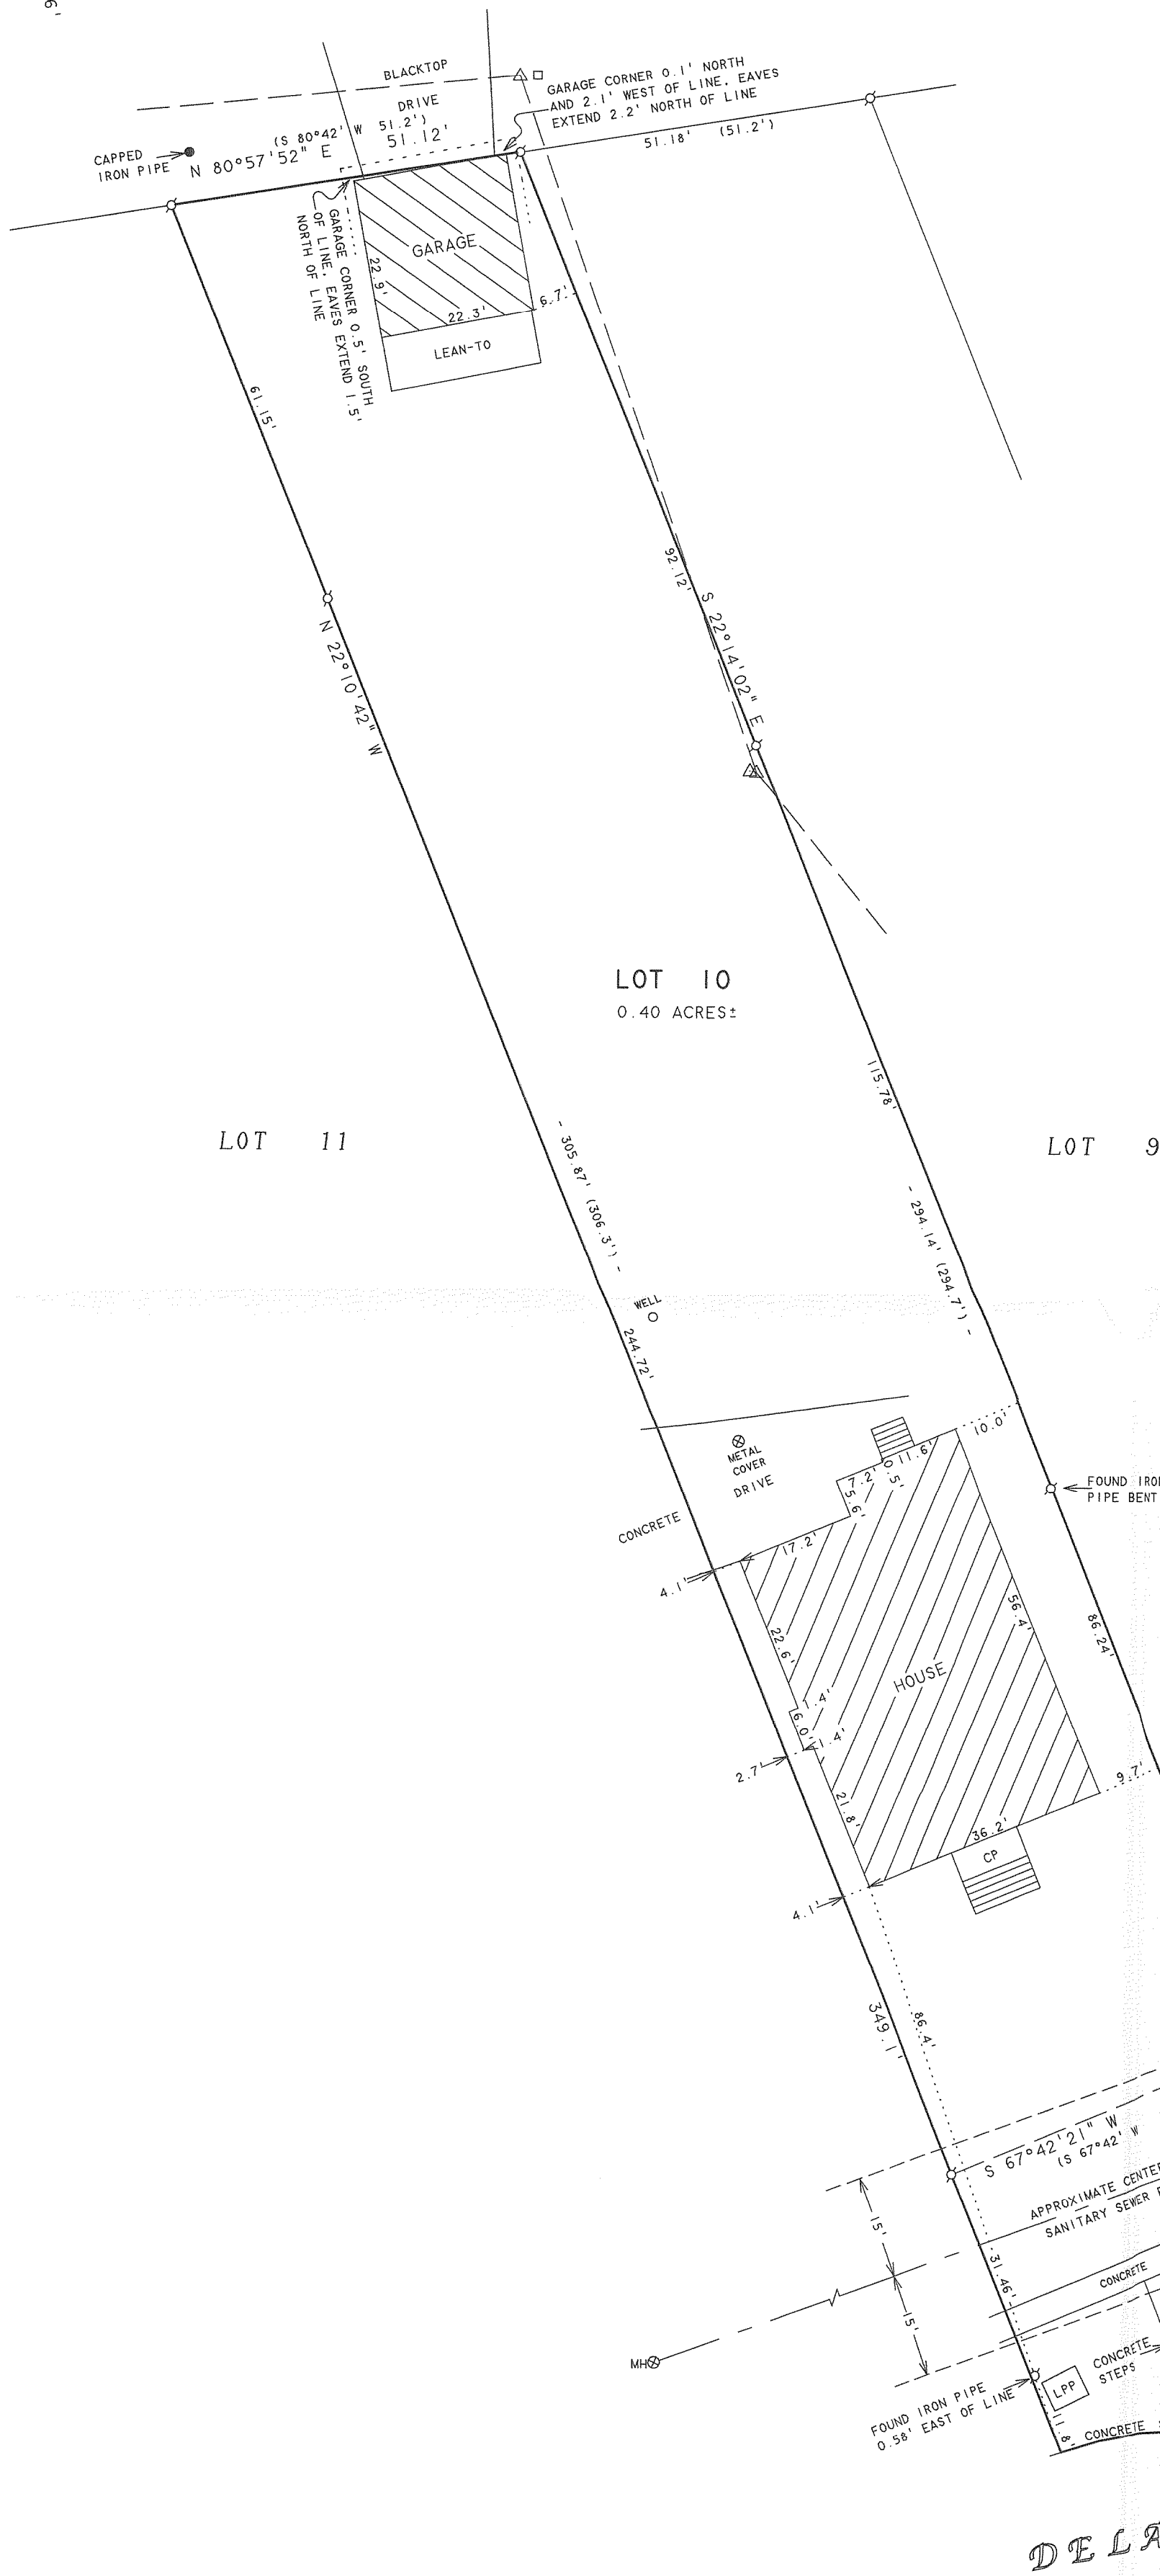

PLAT OF SURVEY OF

LOT 10, ST. MARY'S OF DELAVAN LAKE, LOCATED IN SECTION 28,
T2N,R16E, TOWN OF DELAVAN, WALWORTH COUNTY, WISCONSIN.


NOTE: BEARINGS ARE REFERENCED TO
EXISTING SURVEY RECORDS.



SCALE 1"=20'

LEGEND

- - IRON PIPE FOUND
- △ - UTILITY POLE
- - UTILITY PED
- - OVERHEAD UTILITY LINES
- MH ⊗ - MANHOLE COVER
- CP - CONCRETE PORCH
- LPP - LAKE PUMP PIT
- () - RECORDED AS

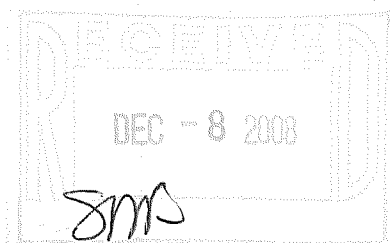

I HEREBY CERTIFY THAT I HAVE SURVEYED THE ABOVE DESCRIBED PROPERTY AND THAT THE
ABOVE MAP IS A TRUE REPRESENTATION THEREOF AND SHOWS THE SIZE AND LOCATION OF
THE PROPERTY, ITS EXTERIOR BOUNDARIES, THE LOCATION OF ALL VISIBLE STRUCTURES
AND DIMENSIONS OF ALL PRINCIPAL BUILDINGS THEREON, BOUNDARY FENCES, APPARENT
EASEMENTS, ROADWAYS AND VISIBLE ENCROACHMENTS, IF ANY, TO THE BEST OF MY
KNOWLEDGE AND BELIEF.

THIS SURVEY IS MADE FOR THE USE OF THE PRESENT OWNERS OF THE PROPERTY, AND ALSO
THOSE WHO PURCHASE, MORTGAGE, OR GUARANTEE THE TITLE THERETO WITHIN ONE (1) YEAR
FROM DATE HEREON.

DAVID F. ABELL
WISCONSIN REGISTERED LAND SURVEYOR, S-1596

ORDERED BY: TIM O'KEEFE
2129 LINN ROAD
DELAVAN, WI 53115

October 28, 2008

DATE: JOB NUMBER - 08043
NOTE: THIS IS NOT A CERTIFIED COPY UNLESS SEALED.

FS-6

216-4617