ABELL SURVEYING & MAPPING

1140 SEQUOIA STREET . DELAVAN, WISCONSIN 53115 262-728-6737

NOTE: ELEVATIONS REFERENCED TO USGS NATIONAL WATER INFORMATION SYSTEM FOR DELAVAN LAKE. LAKE ELEVATION 927.92' ON OCTOBER 1, 2008. . THE FLOODPLAIN FOR DELAVAN LAKE IS 929'



SCALE | " = 20

LEGEND

Ø - IRON PIPE FOUND

- IRON ROD FOUND

- IRON BAR FOUND

8 - PK NAIL FOUND

△ - UTILITY POLE

- UTILITY PEDS 929 5 - SPOT ELEVATION


() - RECORDED AS

HEREBY CERTIFY THAT I HAVE SURVEYED THE ABOVE DESCRIBED PROPERTY AND THAT THE ABOVE MAP IS A TRUE REPRESENTATION THEREOF AND SHOWS THE SIZE AND LOCATION OF THE PROPERTY, ITS EXTERIOR BOUNDARIES, THE LOCATION OF ALL VISIBLE STRUCTURES AND DIMENSIONS OF ALL PRINCIPAL BUILDINGS THEREON. BOUNDARY FENCES. APPARENT EASEMENTS, ROADWAYS AND VISIBLE ENCROACHMENTS, IF ANY, TO THE BEST OF MY KNOWLEDGE AND BELIEF.

THIS SURVEY IS MADE FOR THE USE OF THE PRESENT OWNERS OF THE PROPERTY, AND ALSO THOSE WHO PURCHASE, MORTGAGE, OR GUARANTEE THE TITLE THERETO WITHIN ONE (1) YEAR FROM DATE HEREON.

DAVID F. ABELL WISCONSIN REGISTERED LAND SURVEYOR. S-1596

99102D JOB NUMBER -NOTE: THIS IS NOT A CERTIFIED COPY UNLESS SEALED

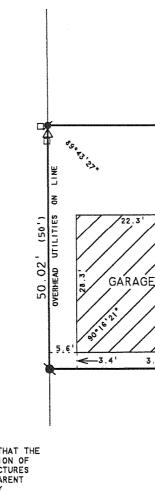

LOT

7

LOT 8

AREA 0.14 ACRES

3.5'→

REVISED AND RECERTIFIED: APRIL 8, 2008

4215 BEACH AVENUE DELAVAN. WI 53115

ORDERED BY: MICHAEL MILLON

WOOD RAMP

LOT PLAT OF SURVEY OF

124.84

125.12

DECK

MOOD

BLACKTOP

LOT 8 OF LAKE DELAVAN HIGHLANDS BEING A SUBDIVISION OF THE SOUTH 1/2 OF THE SE 1/4 OF SECTION 31, T2N, R16E, WALWORTH COUNTY, WISCONSIN.

> REVISED DATE: OCTOBER 1, 2008 REVISED TO SHOW PROPOSED DECK AND SPOT ELEVATIONS ON EASTERLY PORTION OF LOT 8.

930 1

HOÚSE

DRIVE

(125')

930

930 1

(125')

REVISED: JANUARY 28, 2009 TO SHOW NEW DECK ON EAST SIDE OF HOUSE.

ORDERED BY: BARB SMITH

4215 BEACH AVENUE DELAVAN, WI 53115

PK NAIL 1.4' NORTH

OF THE SOUTH EDGE OF

WOOD DECK LOCATED 1/28/09

930 0

.9

89.67\ 28°

11.9

10.01

<u>929</u> 6

0


929 7

12.00

929 5

BLACKTOP DRIVE

SOUTH EDGE BLACKTOP DRIVE

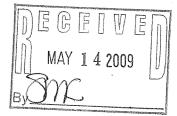

ADJ