
ABELL SURVEYING & MAPPING

1140 SEQUOIA STREET . DELAVAN, WISCONSIN 53115 262-728-6737

SUTTER

AVENUE

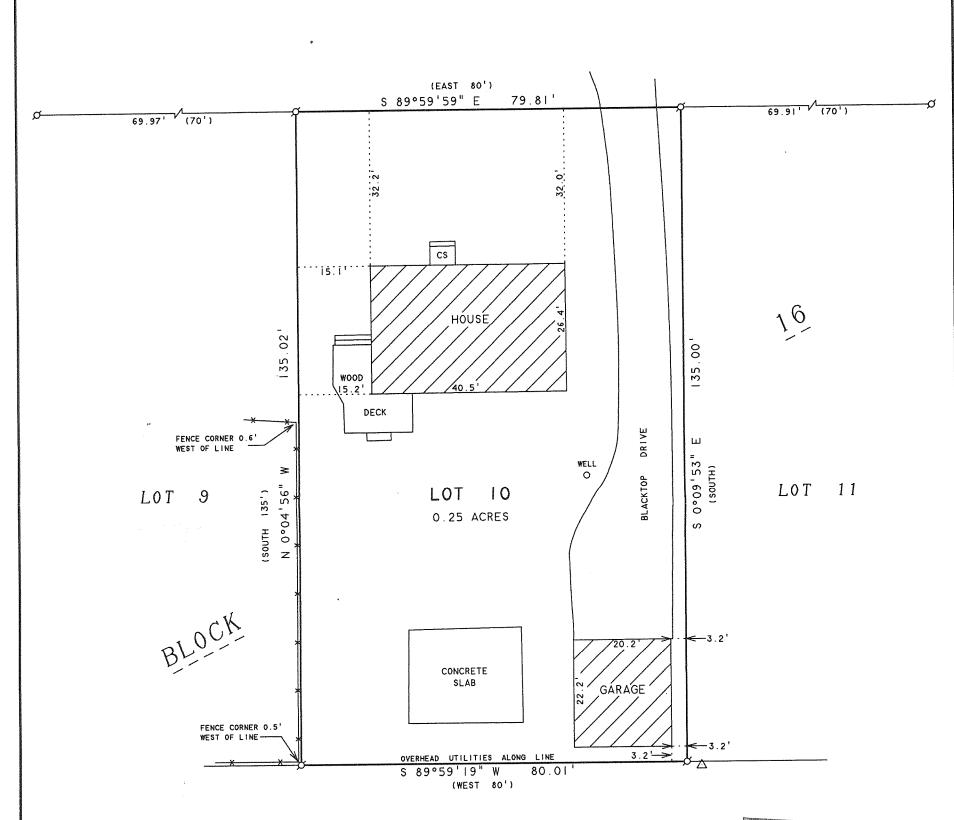

ORDERED BY: KEEFE REAL ESTATE

1155 E. GENEVA STREET

BEARINGS ARE REFERENCED TO THE





SCALE | " = 20 '

LEGEND


Ø - IRON PIPE FOUND -X - CHAINLINK FENCE CS - CONCRETE STOOP

△ - UTILITY POLE

() - RECORDED AS

PLAT OF SURVEY OF

LOT 10. BLOCK 16. DELMAR SUBDIVISION. LOCATED IN T2N, R16E. TOWN OF DELAVAN, WALWORTH COUNTY, WISCONSIN.

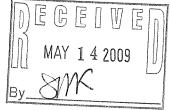

I HEREBY CERTIFY THAT I HAVE SURVEYED THE ABOVE DESCRIBED PROPERTY AND THAT THE ABOVE MAP IS A TRUE REPRESENTATION THEREOF AND SHOWS THE SIZE AND LOCATION OF THE PROPERTY, ITS EXTERIOR BOUNDARIES, THE LOCATION OF ALL VISIBLE STRUCTURES AND DIMENSIONS OF ALL PRINCIPAL BUILDINGS THEREON, BOUNDARY FENCES, APPARENT EASEMENTS, ROADWAYS AND VISIBLE ENCROACHMENTS, IF ANY, TO THE BEST OF MY KNOWLEDGE AND BELIEF.

THIS SURVEY IS MADE FOR THE USE OF THE PRESENT OWNERS OF THE PROPERTY, AND ALSO THOSE WHO PURCHASE, MORTGAGE, OR GUARANTEE THE TITLE THERETO WITHIN ONE (I) YEAR FROM DATE HEREON.

WISCONSIN REGISTERED LAND SURVEYOR, S-1596

March 18, 2009

JOB NUMBER - 09005 DATE JOB NUMBER - NOTE: THIS IS NOT A CERTIFIED COPY UNLESS SEALED

216:4630