


ABELL
SURVEYING & MAPPING
1140 SEQUOIA STREET • DELAVAN, WISCONSIN 53115
262-728-6737

PLAT OF SURVEY OF

LOTS 18-20, BLOCK "D", DELAVAN LAKE
ASSEMBLY GROUNDS, LOCATED IN T2N,
R16E, WALWORTH COUNTY, WISCONSIN.

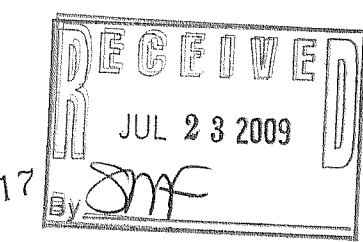

ORDERED BY: RICHARD GRAFF
106 EAGLE POINT
UNIT D
DELAVAN, WI 53115

I HEREBY CERTIFY THAT I HAVE SURVEYED THE ABOVE DESCRIBED PROPERTY AND THAT THE ABOVE MAP IS A TRUE REPRESENTATION THEREOF AND SHOWS THE SIZE AND LOCATION OF THE PROPERTY, ITS EXTERIOR BOUNDARIES, THE LOCATION OF ALL VISIBLE STRUCTURES AND DIMENSIONS OF ALL PRINCIPAL BUILDINGS THEREON, BOUNDARY FENCES, APPARENT EASEMENTS, ROADWAYS AND VISIBLE ENCROACHMENTS, IF ANY, TO THE BEST OF MY KNOWLEDGE AND BELIEF.

THIS SURVEY IS MADE FOR THE USE OF THE PRESENT OWNERS OF THE PROPERTY, AND ALSO THOSE WHO PURCHASE, MORTGAGE, OR GUARANTEE THE TITLE THERETO WITHIN ONE (1) YEAR FROM DATE HEREON.

David F. Abell
DAVID F. ABELL
WISCONSIN REGISTERED LAND SURVEYOR, S-1596

August 29, 2005
DATE

JOB NUMBER - 05109D
NOTE: THIS IS NOT A CERTIFIED COPY UNLESS SEALED.

REVISED: OCTOBER 20, 2005 TO
SHOW THE PROPOSED HOUSE, COVERED
PORCH AND DECK.

REVISED: NOVEMBER 7, 2005 TO SHOW
THE NEW LOCATION OF THE PROPOSED
HOUSE, COVERED PORCH AND DECK.

REVISED: FEBRUARY 20, 2006 TO SHOW
FOUNDATION OF HOUSE UNDER CONSTRUCTION.

REVISED: MARCH 2, 2006 TO SHOW
CHANGES IN FOUNDATION DIMENSIONS
AND PERPENDICULAR OFFSET.

ORDERED BY: ZELL'S WOODWORKING
1299 CENTER STREET
DELAVAN, WI 53115

NOTE: OFFSET DIMENSIONS FOR HOUSE
UNDER COUSTRUCTION ARE TO THE
CONCRETE FOUNDATION.

FDLA-57

216-4657